


Section 3 Township 24 Range 24W

Well No. 3 Schraider (*Schraeder*)

Company M. B. Armer & Coplin

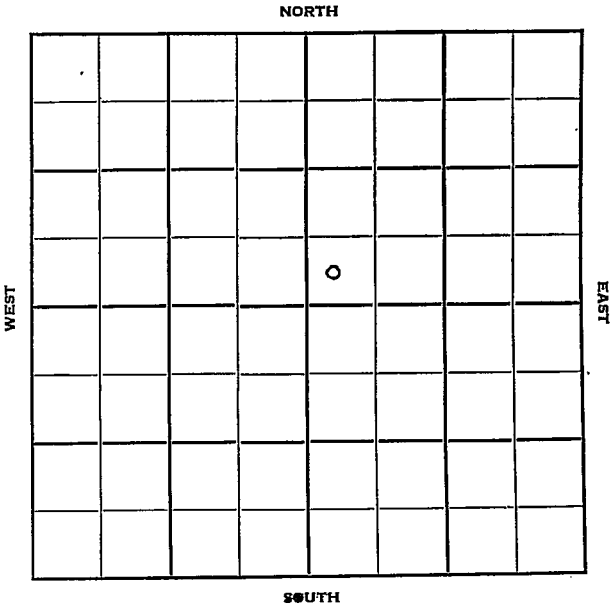

Sec. 3 Twp. 24 R. 24W ✓

Well No. #3 Schraider Farm

M. B. Armer & Coplin Company

Contractor

Purdyville Pool


Ft. from N. Line

330' Ft. from S. Line

Ft. from E. Line

330' Ft. from W. Line

SW SW NE

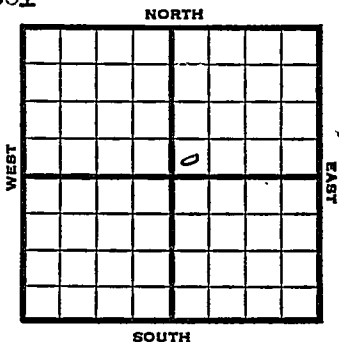

1951 Elev 2478' REPORT

7/25 Spud 7-19-51
8" @ 377
Drlg. 2543

10/3 Spud 7-19-51
Oil well TD 4696' 8" @ 377
Heeb 3943' KC 4022' Marm. 4407'
Miss. 4672'
DST 4685-93 open 1 hr. rec 2520'
clean oil 500 A 5" @ 4685'
S/42 BOPH
Comp.81 BOPD

COMPLETED

County Hodgeman State Kansas

Sec. 3 (Blk.) 24 (Sur. Rge.) 24W Map No.

Operator M. B. Armer & Coplin

Well No. 3 Farm Schraider

Elev. Location SW SW NE

330 Ft. From S Line NE

330 Ft. From W Line Quarter

Ist. Report JUL 25 1951

Completion

Remarks

Spudding Date 7-19-51

Drlg. Data Purdyville Pool

8" @ 377 drlg. 2543

J. E. TYRA

