


KANSAS Finney

FORM 51 25M 3-49 PETROL

Section ~~2~~ **3** Township **24** Range **34-N**

Well No. **#1 Potter**

Company **Champlin**
Hugoton Pool

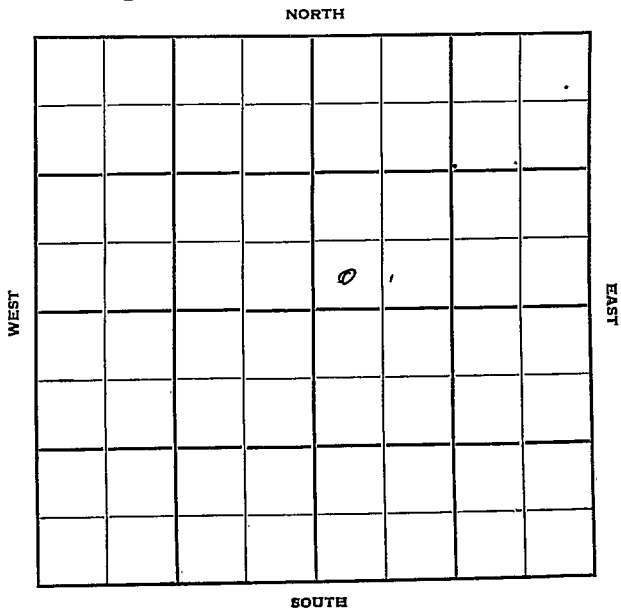

Sec. 3- Twp. 24 R. 34W

Well No. #1 Ernest Potter Farm

Champlin Ref. Company


Hugoton (Champlin Ref., Cont.)

 Ft. from N. Line

330' Ft. from S. Line

330' Ft. from E. Line

 Ft. from W. Line

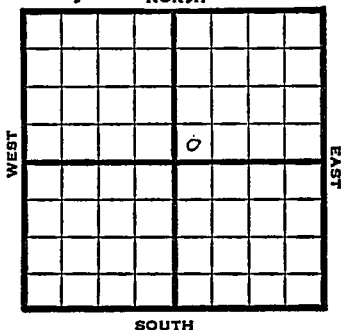

SW NE

SOUTH

1949 Elev 2925' REPORT

10/19 Drlg. 310'
 10/26 10" @ 805'
 TD 2588'
 7" @ 2588'
 11/1 "
 11/9 318 shots 2427-2569
 9500 acid
 11/16 10000 acid
 11/23 "
 11/29 "
 12/7 "
 12/14 "
 12/21 TD 2588'
 7"@ 2588'
 Perf
 19500 acid
 6,242,000 Gas
 390# R Pr.
 Comp

COMPLETED

Map No. _____ Sec. 2 Twp. 24 R. 34W

Well No. 1 Potter

Champlin Ref. _____ Company _____

Champlin _____ Contractor _____

SW NE

**FIRST REPORT
SECTION PLAT**

_____ Ft. from N. Line

330 Ft. from S. Line

_____ Ft. from E. Line

330 Ft. from W. Line

Finney County

Location _____

Rig up _____

Drilling and Remarks:

R U R

RECORD

Cased _____ in., _____ ft.

Sand _____

Gas _____

Oil _____

Total Depth _____

PRODUCTION

1st 24 hrs. Nat. _____

1st 24 hrs. after shot _____

Gas _____ Cu. Ft.

Dry Hole _____

Abandoned _____

Date

OCT 26 1949 19

S. J. LEWIS Scout

Map No. _____ Sec. 3 Twp. 24 R. 34W

Well No. I Potter

Champlin Ref. _____ Company _____

CORRECTION _____ Contractor _____

SW NE

SECTION PLAT

_____ Ft. from N. Line

330 Ft. from S. Line

_____ Ft. from E. Line

330 Ft. from W. Line

Finney County

RECORD

Location _____

Cased _____ in., _____ ft.

Rig up _____

Sand _____

Drilling and Remarks:

Gas _____

Oil _____

Total Depth _____

Reported in _____

PRODUCTION

2-24-34W

1st 24 hrs. Nat. _____

1st 24 hrs. after shot _____

Gas _____ Cu. Ft.

Dry Hole _____

Abandoned _____

Date

NOV 9 1949 19

S. J. LEWIS Scout