

KANSAS

FORM 51 5M 4-41 PETROL

Harvey

Section 30 Township 24 Range 2-W

Well No. #1 Williams

Company Atlantic Oil & Investment

		NORTH				Wildcat	
WEST							
							0
		SOUTH					

EAST

KANSAS


Harvey

Sec. 30 Twp. 24 R. 2-~~W~~Well No. #1 Williams FarmAtlantic Oil & Investment Company

(Wildcat)

 Ft. from N. Line330 Ft. from S. Line330 Ft. from E. Line Ft. from W. Line

Elev. 1411

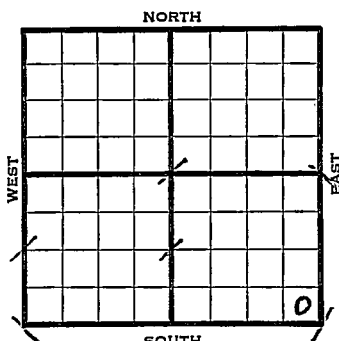


1942	REPORT
6/10	Location
6/17	"
6/24	"
7/1	"
7/8	"
7/15	Cellar.
7/22	15" - 226 13" - 408'
	Drlg. 682'
7/29	10" - 450 8" - 1135 Drlg.
8/5	Lens. 2535 Drlg. 2970'
8/12	Miss 3365 TD 3760
8/19	B. Miss. 3795 Hunton 3837
	Viola 3915 Simp. 3940
	Arb. 4033
	T.D. 4091 S.D.
8/27	Arb. 4033
	no shows
	T.D. 4091
	ABANDONED

Map No. 39 Sec. 30 Twp. 24 R. 2WWell No. 1 WilliamsAtlantic Oil & Investment Company**FIRST REPORT**

Contractor

SE/C

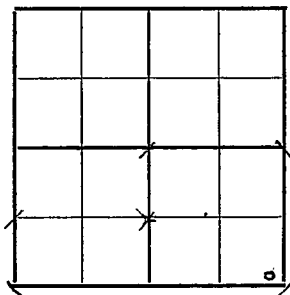SECTION PLAT Ft. from N. Line330 Ft. from S. Line330 Ft. from E. Line Ft. from W. Line**WILDCAT**Location XXRig up

Drilling and Remarks:

RECORDCased in., ft.Sand Gas Oil Total Depth **PRODUCTION**1st 24 hrs. Nat. 1st 24 hrs. after shot Gas Cu. Ft.Dry Hole Abandoned

Date

JUN 10 1942

19

S. J. LEWIS Scout

Harvey

Map No. 39 Sec. 30 Twp. 24 R. 2WWell No. 1 WilliamsAtlantic Oil & Investment CompanyABANDONED

Contractor

SE/C

SECTION PLAT

			6

Ft. from N. Line

330 Ft. from S. Line330 Ft. from E. Line

Ft. from W. Line

WILDCAT

RECORD

Location _____

Cased _____ in., _____ ft.

Rig up _____

Sand _____

Drilling and Remarks:

Gas _____

Cr 4033

Oil _____

*Nochoas*Total Depth 4091

PRODUCTION

1st 24 hrs. Nat. _____

1st 24 hrs. after shot _____

Gas _____ Cu. Ft.

Dry Hole _____

Abandoned _____

Date

AUG 27 1942 19S. J. LEWIS Scout