


Section.....30.....Township.....24.....Range.....4-W.....

Well Number.....2 Mueller.....

Company.....I.T.I.O.....

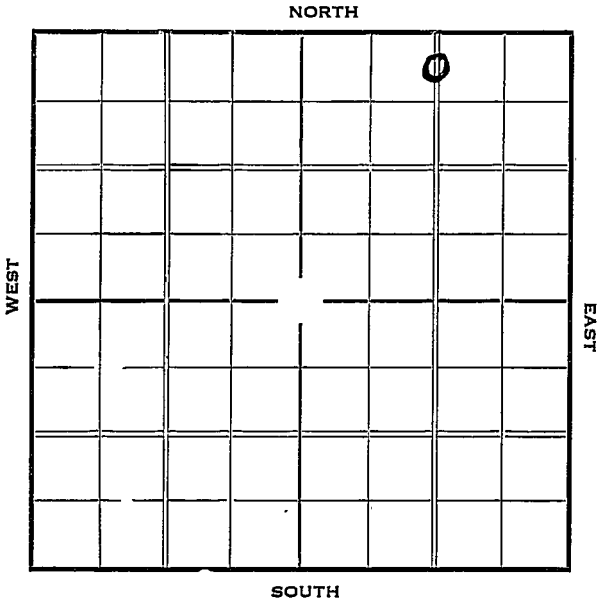

KANSAS *Renor*Map No. _____ Sec. *30* Twp. *24* R*4W*Well No. *2 Mueller**L. T. L. O.* Company

Contractor

SECTION PLAT

			0

830 Ft. from N. Line

_____ Ft. from S. Line

1320 Ft. from E. Line

_____ Ft. from W. Line

FIRST REPORT

Location _____

Rig up _____

Drilling and Remarks:

Rigging up

RECORD

Cased _____ in., _____ ft.

Sand _____

Gas _____

Oil _____

Total Depth _____

PRODUCTION

1st 24 hrs. Nat. _____

1st 24 hrs. after shot _____

Gas _____ Cu. Ft.

Dry Hole _____

Abandoned _____

Date

APR 21 1937

19

S. J. LEWIS Scout

Reno KANSAS

Map No. 40 Sec. 30 Twp. 24 R. 4WWell No. 2-MuellerJ. F. L. O. Company

____ Contractor

COMPLETED

SECTION PLAT

330 Ft. from N. Line

____ Ft. from S. Line

1320 Ft. from E. Line

____ Ft. from W. Line

			0

Location _____

Rig up _____

Drilling and Remarks:

1500 AcidPat 548Pump

RECORD

Cased 7 in., 3335 ft.Sand Chat 3333

Gas _____

Oil _____

Total Depth 3376

PRODUCTION

1st 24 hrs. Nat. _____

1st 24 hrs. after shot _____

Gas _____ Cu. Ft.

Dry Hole _____

Abandoned _____

Date

MAY 26 1937

19

H. D. Hatfield Scout