


Section 30 Township 24 Range 4-W


Well Number 4 Mueller

Company Haynes Drlg.

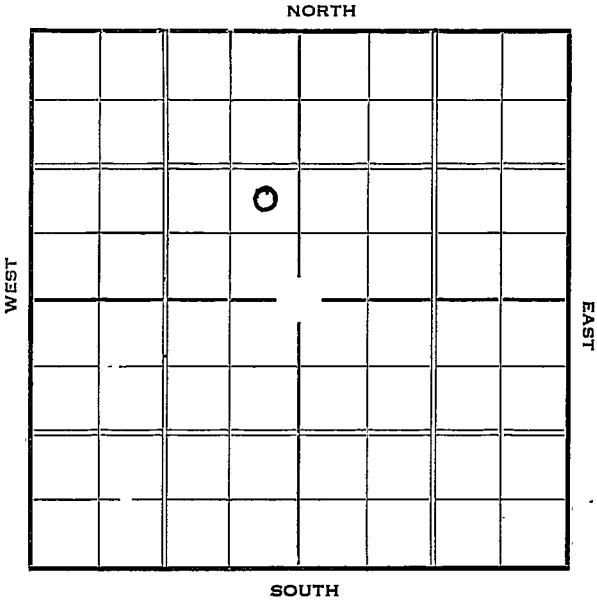

Sec. 30 Twp. 24 R. 4-WWell No. #4 Mueller FarmHaynes Drlg. Company Ft. from N. Line990 Ft. from S. Line330 Ft. from E. Line Ft. from W. Line

Elev. 1475

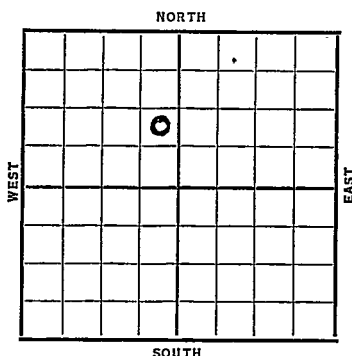

Date

REPORT

1937

5/12 B. R. R.

5/21 10" @ 551'. WOC.

5/28 Drlg. 1916'.

6/4 Drlg. 3305'.

6/11 Chat 3343'. 7" @ 3345'.

T.D. 3400'. Swab 12 oil P.H.

12 hrs.

6/16 7" @ 3345'.

Cha t 3343'.

T.D. 3400'.

1000 acid.

Pot. 509 bbls.

30% water.

COMPLETED

KANSAS

Map No. 40 Sec. 30 Twp. 24 R. 4WWell No. 4-MuellerHaynes Drilling Company

Contractor

FIRST REPORT

SECTION PLAT

	0		

_____ Ft. from N. Line

990 Ft. from S. Line330 Ft. from E. Line

_____ Ft. from W. Line

Location _____

Rig up _____

Drilling and Remarks:

B.R.R.

RECORD

Cased _____ in., _____ ft.

Sand _____

Gas _____

Oil _____

Total Depth _____

PRODUCTION

1st 24 hrs. Nat. _____

1st 24 hrs. after shot _____

Gas _____ Cu. Ft.

Dry Hole _____

Abandoned _____

Date

MAY 12 1937 19

H. D. Hatfield

Scout

Reno KANSAS

Map No. 40 Sec. 30 Twp. 24 R. 4WWell No. 4-MillerHaynes Drilling Company

Contractor

COMPLETED

SECTION PLAT

	0		

_____ Ft. from N. Line

990 Ft. from S. Line330 Ft. from E. Line

_____ Ft. from W. Line

Location _____

Rig up _____

Drilling and Remarks:

1000 AcidPat 50930 90 wat

RECORD

Cased 7 in., 3345 ft.Sand Chat 3343

Gas _____

Oil _____

Total Depth 3400

PRODUCTION

1st 24 hrs. Nat. _____

1st 24 hrs. after shot _____

Gas _____ Cir. Ft.

Dry Hole _____

Abandoned _____

Date

JUN 16 1937 19

H. D. Hatfield

Scout