


SECTION 30 TOWNSHIP 24 RANGE 11W

WELL NO. #1 Davis

COMPANY C.R.A. & Rex & Morris

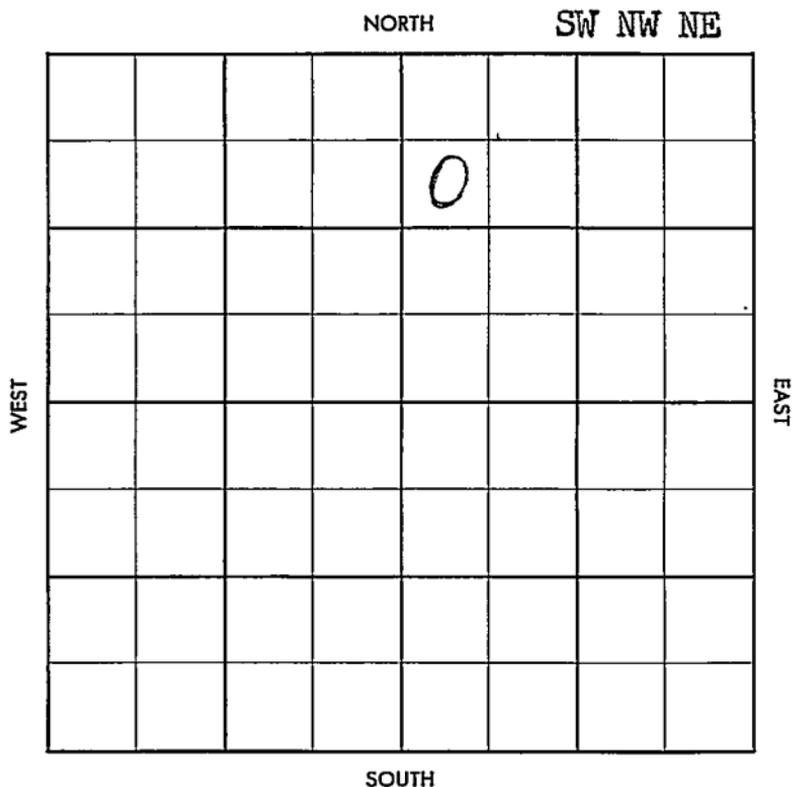





P 1030 8098W 24hrs

OCT 23 '57 P 830 8098 24hrs

OCT 30 '57 P 8 1/2 30BW 24hrs

NOV 6 '57 NOV 20 '57 NOV 27 '57 DEC 4 '57

night nework 1140 . . . SD

DEC 26 '57 pulled T6R C03904

1.16B0 2.90BW 1hr

D03908 1/2 3B0 18BW 4

5hrs 3.48 B0 3.0BW 3hrs

PB 3907 1/2 3.48 B0 5BW

9hrs P 08 P no 199 BW

22hrs w00 JAN 2 '58 P 21B0 154BW

24hrs JAN 3 '58 P 23B0 139BW 24hrs

JAN 15 '58 P 17B0 133BW 24hrs

JAN 22 '58

17B0 133BW 24hrs