

DX 78-1


Stafford

KANSAS

Section 30 Township 24 Range 11W

Well No. #2 Irvine "A"

Company C R A & Rex & Morris

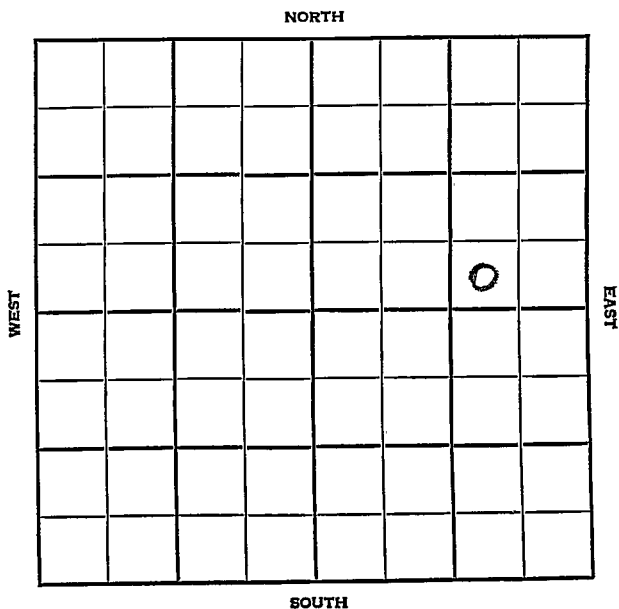

Stafford

KANSAS

SEC.	TWP.	R.
30	24	11W

WELL NO.

2' Irvine "A"

FARM

COMPANY

CRA & Rex & Morris

CONTRACTOR

CRA

Mo-Pac pool

Ft. from N. Line

330'


Ft. from S. Line

990'

Ft. from E. Line

Ft. from W. Line

SW SE NE

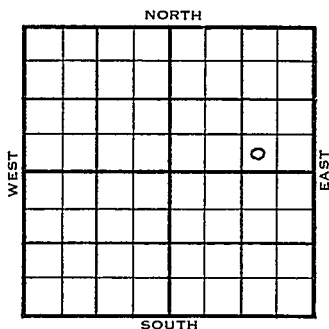

1955

ELEVATION

1835'

REPORT

5/25

Location

7/20

Comm: 6-2-55

8 5/8" @306/200 5 1/2" @3892/75

CO to 3894 2/3bho & m 1/3 bo DD 3894,

3 1/2bf 65% w DD 3896 DD 3898 FU 1900',

fluid S/63 bo 25 bw 4 hr. P/4bo 14 bw

6 hr. P/50 bo 64 bw 20hr. P/44 bo 97bw

24 hr. Comp. 53 bopd. 65% wtr.

Tops:

Depth

Datum

Bl.

3433

1598

L.

3465

1630

V.

3891

2056


TD.

3893

Comp: 7-20-55

COMPLETED

County Stafford State Kansas
 Sec. 30 (Blk. 24 Twp.) (Sur. 11W Rge.) Map No.
 Operator C R A & Rex-& Morris
 Well No. 2 Farm Irvine "A"
 Elev. Location SW SE NE

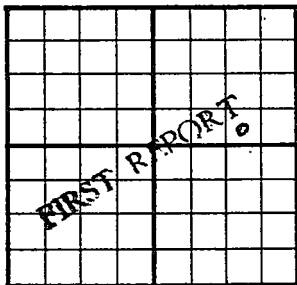

330 Ft. From S Line NE
990 Ft. From E Line Quarter
 1st. Report MAY 25 1955
 Completion
 Remarks CRA - Contr.
 Spudding Date

Drilg. Data Mo-Pac Pool

Location

SCOUT TICKET

DX-201

KANSAS

SEC.

30

TWP.

24

R.

11W

WELL NO.

2 Irvine "A"

FARM

COMPANY

C R A & Rex & Morris

CONTRACTOR

CORRECTION

SW SE NE

____ FT. FROM N. LINE

330


____ FT. FROM S. LINE

990

____ FT. FORM E. LINE

____ FT. FROM W. LINE

NORTH

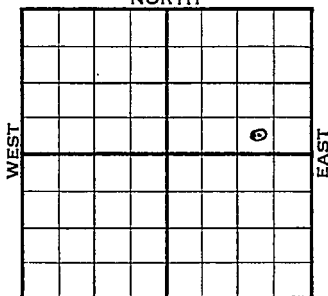

SOUTH

Stafford County

☐ LOCATION☐ RIG UP

DRILLING AND REMARKS:

Completed

7-20-55

30-24S-13W

RECORD

CASED IN., FT.

SAND

GAS

OIL

TOTAL DEPTH

1ST 24 HRS. NAT.

1ST 24 HRS. AFTER SHOT

GAS CU. FT.

DRY HOLE

ABANDONED

PRODUCTION

DATE

JUL 20 1955

SCOUT

L. J. Harris

County Stafford Elev. 1835
 Sec. 30 Twp. 24 Rge. 13W-11W
 Company C R A & R_ex & Morris
 Farm Name Irvine "A" No. 2

TOPS	DEPTH	LOG	DATUM	Loc. in Sec.
Anh.				SW SE NE
Tr.				
Dg.				
Bl.	3433		1598	
L.	3465		1630	Geol.
K.C.				Contr.
B.K.C.				C R A
Ce.				Pool
C.				Mo-Pac
M.				
M.				
K.				
Mz.				
Mo.				
V.	3891		2056	
S.				
S.				
A.				
R.				
Pe.				
G.				
T.D.	3893			

COMPLETE

Date Comm. "6-2-55 JUL 2 0 1955
8 5/8" @ 306/200 5 1/2" @ 3892/75
CO to 3893 2/3 b ho & m 1/3 bo
DD 3894 3 1/2 bf 65% w DD 3896
DD 3898 FU 1900' fluid S/ 63 bo 25 bw
4 hr. P/ 4 bo 14 bw 6 hr. P/ 50
bo 64 bw 20 hr. P/ 44 bo 97 bw 24 hr.
Comp. 53 bopd 65% wtr.

(See correction
attached)