

KANSAS


Stafford

FORM 51 5M 1-42 PETROL

Section 30 Township 24 Range 12-W

Well No. #1 Cline

Company Continental

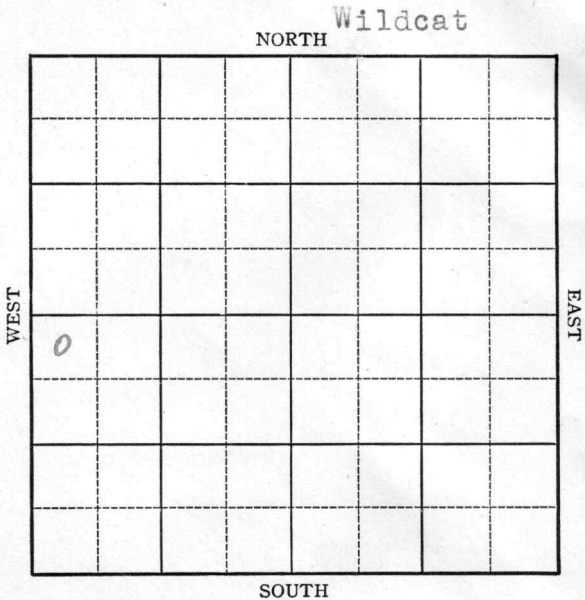

Stafford

KANSAS

Map No. 47 Sec. 30 Twp. 24 R. 12WWell No. 1 ClineContinental CompanyFIRST REPORT Contractor

NW SW

SECTION PLAT

330 Ft. from N. Line Ft. from S. Line Ft. from E. Line330 Ft. from W. Line

o			

WILDCAT

Location Rig up

Drilling and Remarks:

10" - 443'Waiting on
cement to set

RECORD

Cased in., ft.Sand Gas Oil Total Depth

PRODUCTION

1st 24 hrs. Nat. 1st 24 hrs. after shot Gas Cu. Ft.Dry Hole Abandoned

Date

MAR 4 1942 19S. J. LEWIS Scout

Map No. 47 Sec. 30 Twp. 24 R. 12WWell No. 1 ClineContinental CompanyABANDONED Contractor

NW SW

330 Ft. from N. Line Ft. from S. Line Ft. from E. Line330 Ft. from W. Line

SECTION PLAT

0			

WILDCAT

Location Rig up

Drilling and Remarks:

Cat 4164
Noshoro.

RECORD

Cased in., ft.Sand Gas Oil Total Depth 4225

PRODUCTION

1st 24 hrs. Nat. 1st 24 hrs. after shot Gas Cu. Ft.Dry Hole Abandoned

Date

MAR 25 1942 19S. J. LEWISScout