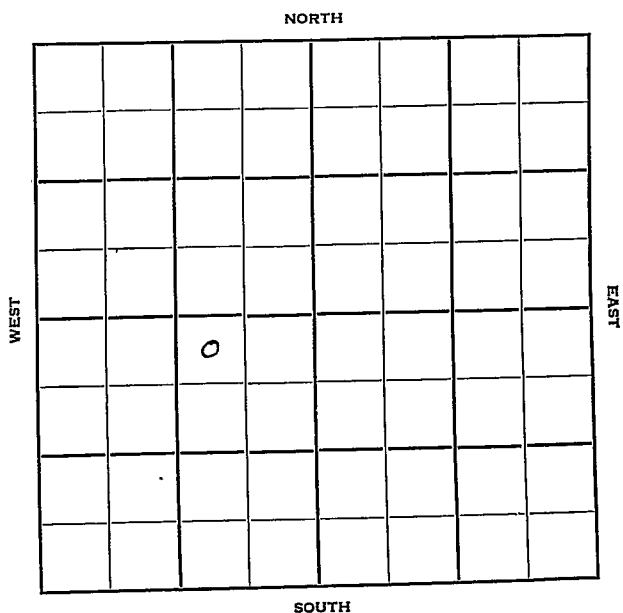


Section 30 Township 24 Range 13-WWell No. #2 HarterCompany L. B. Stablefard

Sec. 30 Twp. 24 R. 13-W

Well No. #2 Harter Farm

L. B. Stableford Company

Contractor


330 Ft. from N. Line

Ft. from S. Line

990 Ft. from E. Line

Ft. from W. Line

NW NE SW

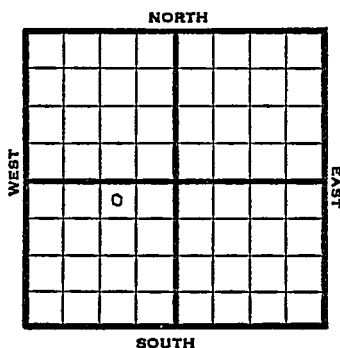

1950

Elev 1941

REPORT

6/7

Location (5-3)

8" @ 244

Anhy 820-45

Drlg 2100

8/2

8" @ 244

Anhy 820-45

Lans 3595

DST 3748-76, opn 12 min

rec 430' oil

Kinderhook 3942 Viola 3978

Simp 4133

Simp sd 4148

Arb 4180-88 TD

5" @ 4188 FU 3700' oil in 9 hr

Comp 81 bopd 2% wtr

Completed

COMPLETED

KansasMap No. _____ Sec. 30 Twp. 24 R. 13WWell No. 2 Harter

L. B. Stableford

Company _____

Contractor _____

NW NE SW

E1. 1941
SECTION PLAT330 Ft. from N. Line

Ft. from S. Line

990 Ft. from E. Line

Ft. from W. Line

	0		

FIRST REPORT

Stafford

Location X

Rig up _____

Drilling and Remarks:

8" @ 244

Anhy 820-45

drlg. 2100

RECORD

Cased _____ in., _____ ft.

Sand _____

Gas _____

Oil _____

Total Depth _____

PRODUCTION

1st 24 hrs. Nat. _____

1st 24 hrs. after shot _____

Gas _____ Cu. Ft.

Dry Hole _____

Abandoned _____

Date

JUN 7 1950 19

J. E. TYRA Scout

Map No. _____ Sec. 30 Twp. 24 R. 13WWell No. 2 HarterL. B. Stablefard Company**CORRECTION** Contractor


NW NE SW

E1. 1941
SECTION PLAT330 Ft. from N. Line

_____ Ft. from S. Line

990 Ft. from E. Line

_____ Ft. from W. Line

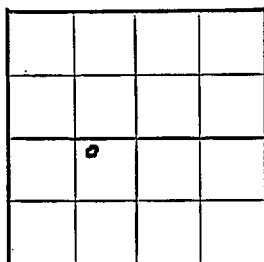

Stafford Co.

Location _____

Rig up _____

Drilling and Remarks:

Reported

C N/2 NW SW

RECORD

Cased _____ in., _____ ft.

Sand _____

Gas _____

Oil _____

Total Depth _____

PRODUCTION

1st 24 hrs. Nat. _____

1st 24 hrs. after shot _____

Gas _____ Cu. Ft.

Dry Hole _____

Abandoned _____

Date


MAY 31 1950

19

J. E. TYRA

Scout

County Stafford State Kansas
 Sec. 30 (Blk. 24 (Sur. 13W Map No.
 (Twp.) (Rge.)
 Operator L. B. Stableford
 Well No. 2 Farm Harter
 Elev. 1941 Location NW NE SW

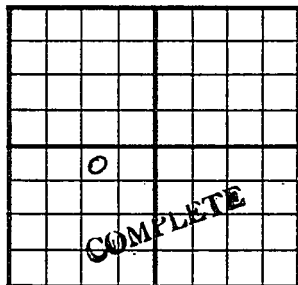

330 Ft. From N Line SW
990 Ft. From E Line Quarter

Ist. Report

Completion AUG 2 1950

Remarks

Spudding Date

Drlg. Data

8" @ 244 Anhy 820-45 Lans. .3595

DST 3748-76 open 12 min. Rec. 430' oil

Kinderhook 3942 Viola 3978 Simp. 4133

Simp. sd. 4148 Arb. 4180-88 TD

5" @ 4188 FU 3700' oil in 9 hr.

Comp. 81 bopd 2% water

J. E. TYRA