

SECTION 30 TOWNSHIP 24S RANGE 14W

WELL NO. #1-Hyter

COMPANY Sunray Mid-Cont. Oil

SW SW SW

NORTH

0							

WEST

EAST

SOUTH

# HOT FILE KANSAS


SEC. 30 TWP. Stafford R. 24 S 14 W

WELL NO. # 1 E. Hyter FARM

COMPANY Sunray Mid-Continent (DEVELOPMENT)

CONTRACTOR Stickle Drlg.  
Saterlee Field.

\_\_\_\_\_ FT. FROM N. LINE  
330 \_\_\_\_\_ FT. FROM S. LINE  
\_\_\_\_\_ FT. FROM E. LINE  
330 \_\_\_\_\_ FT. FROM W. LINE

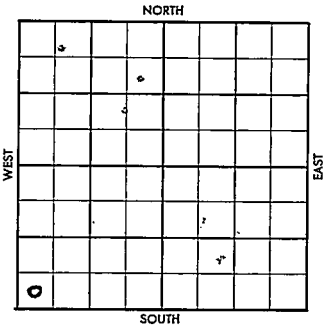

of Sec.  
SW SW SW

DATE	ELEVATION REPORT
<u>1957</u>	<u>4400' Arbuckle Test</u>
<u>7/23</u>	<u>RURT (FR Tkt) (DR#142)</u>
<u>7/24</u>	<u>Spudded 7-23-57</u> <u>TD 312' WOC. 8-5/8" @ 310'</u>
<u>7/25</u>	<u>Drlg. 1100'</u>
<u>7/26</u>	<u>Drlg. 2300'</u>
<u>7/29</u>	<u>Drlg. 3276'</u>
<u>7/30</u>	<u>Drlg. 3540'</u>
<u>7/31</u>	<u>Drlg. 3763'</u>
<u>8/1</u>	<u>Drlg. 3916'</u>
<u>8-2</u>	<u>Drlg. 4066'</u>
<u>8-5</u>	<u>Drlg. 4374'.</u>
<u>8-6</u>	<u>TD 4377'. Prep to run csg.</u>
<u>8-7</u>	<u>TD 4377'. WOC. 5 1/2" @ 4362'.</u>
<u>8-8</u>	<u>TD 4377'. " "</u>
<u>8/9</u>	<u>TD 4377'. Prep to drill plug &amp; test.</u>
<u>8/12</u>	<u>TD 4377'. Instl. pumping unit.</u>
<u>8/13</u>	<u>TD 4377' " "</u>
<u>8/14</u>	<u>" " "</u>
<u>8/15</u>	<u>TD 4377' " "</u>
<u>8/16</u>	<u>" " "</u>
<u>8/19</u>	<u>" " "</u>

OVER

1957			
8/20	TD 4377'	Instl.	pumping unit.
8/21	TD 4377'	"	"
8/22	TD 4377'	WO State	test.
8/23	TD 4377'	"	"
8/26	TD 4377'	"	"
8/27	"	"	"
8/28	TD 4378'	"	"
8/29	TD 4377'	Pumped 192 BO in 24	
		hrs. open hole 4362-4377', Arbuckle	
		Zone. Complete	(DR#169)

7207 d 3 JUL

M.M

FORM 513 SUNRAY

County Stafford Elev. \_\_\_\_\_  
 Sec. 30 Twp. 24 Rgs. 11W  
 Company Sunray Mid-Continent  
 Farm Name Hyster No. 7

TOPS	DEPTH	LOG	DATUM
Anh.			
Tr.			
H.			
Tr.			
Dg.			
Bl.			
L.			
K.C.			
B.K.C.			
Ce.			
C.			
M.			
M.			
K.			
Mz.			
Mq.			
V.			
S.			
S.			
A.			
R.			
Pe.			
G.			
T.D.			

Loc. in Sec. \_\_\_\_\_  
 SW SW SW  
 Geol. \_\_\_\_\_

Stickle  
 Pool FARMINGTON  
 Satterlee

JUL 24 '57  
 FIRST REPORT

Date Comm. Cellar & pits

~~13~~

County Stafford Elev. 1777  
 Sec. 30 Twp. 24 Rge. 14W  
 Company Sunray Mid-Continent  
 Name Hyter No. 1

Co.

	DEPTH	LOG	DATUM	Loc. in Sec.
Sp.				SW SW SW
H.	3574			
Tr.				
Dg.				
Bl.	3714			
L.	3772			
K.C.				Geol.
B.K.C.				Contr.
Ce.				<del>Stickle</del>
C.				
M.				Pool <u>FARMINGTON</u>
M.				<u>Satterlee</u>
K.				
Mz.				
Mo.				
V.	4220			
S.	4322			
S.				COMPLETE
A.	4360			
R.				
Pe.				SEP 4 '57
G.				
T.D.	4377			

Log

No.

Sec.

T.

R.

Date Comm.

Cellar & pits 59.31 47' spd 7-25-57

8 3/8 @ 310/300 @ 3540 AUG 8 57

Log taps DST 4360-77 @ 90"

rec 75' HOCM FP 330-47 BHP

1135/20" RTD 4377 Log 5 1/2 @

4361 WOCT AUG 4 57 MICT CO 4377

fst 4 Goph DD 4380 @ 5 Goph

wt? no time DD 4383 TD @ 7

Goph no/wts 1 1/2 rec hd. S.

169,55 BO no/w in 4 hrs  
\$ 2000' O.B. T & R POP. AUG 21 '57

18<sup>th</sup> Equip. AUG 26 '57 SEP 4 '57 X PHP

~~1930<sup>+</sup> 13<sup>o</sup> gr 33<sup>o</sup>~~

PHP 193 BO pd + 13<sup>o</sup>, Wtr gr. 33<sup>o</sup>

30-24-14 W

SW SW SW