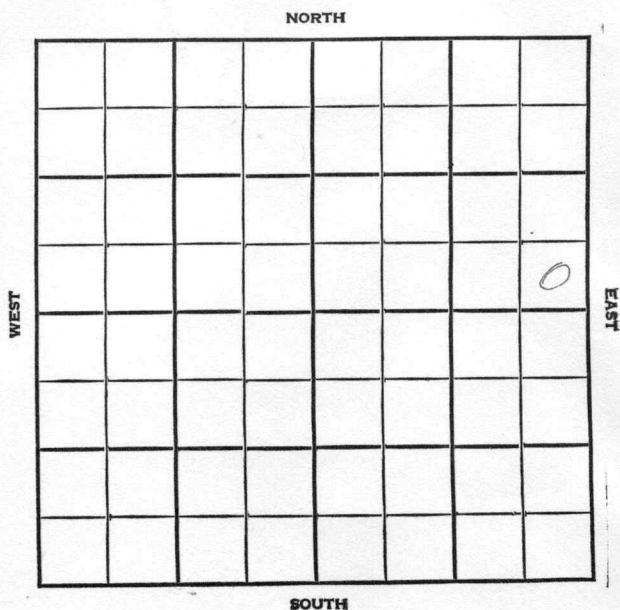


Section 30 Township 24 Range 15WWell No. #1 J.E. SeibertCompany Skelly Oil

County Stafford Elev. _____
 Sec. 30 Twp. 24 Rge. 15W
 Company Skelly Oil
 Farm Name J. E. Seibert No. 1

TOPS	DEPTH	LOG	DATUM	Loc. in Sec.
Anh.	<u>1019</u>			<u>SE SE NE</u>
Tp.				
H.				
Tr.				
Dg.				
Bl.				
L.				
K.C.				Geol. _____
B.K.C.				Contr. _____
Ce.				<u>Wentworth</u>
C.				
M.				Pool _____
M.				<u>NW Farmington</u>
K.				
Mz.				
Me.				
V.				
S.				
S.				
A.				
R.				
Pe.				
G.				
T.D.				

	NDV 1456	

FIRST REPORT

Date Comm. 11-11-568" @ 1034 WOG

Co.

Lse.

No.

Sec.

T.

R.

County Stafford Elev. 2045
 Sec. 30 Twp. 24 Rge. 15W
 Company Skelly Oil
 Farm Name J. E. Seibert No. 1

TOPS	DEPTH	LOG	DATUM	Loc. in Sec.
Anb.	1019			SE SE NE
Tr.				
H.	3639			
Tr.	3658			
Dg. <u>sd</u>	3676			
Bl.	3778			
L.	3787			
K.C.				Geol.
B.K.C.	4050			Contr.
Ce. <u>Marm</u>	4110			Wentworth
C.	4180			
M.	4264			Pool
M.				NW Farmington
K. <u>sd</u>	4300			
Mz.				
Ma				
V.	4349			
S.				
S.				
A.				
R.				
PE.				
G.				
T.D.	4400			

ABANDONED

Date Comm. 11-11-56

8" @ 1034 WOC NOV 21 '56 3230 NOV 28 '56

DST 3902-30 1 hr. rec. 122' SW
 FP 30-75 BHP 1284 20" DST
 4258-85 1 hr. G 1/12" ga 58 MCF
 115" 88 MCF 145" rec 110' USGCM
 BHP 1196 120" FP 45-62
 DST 4284-4330 1 hr. 48' Md FP
 45-62 BHP 107 120" DST 4334-4400
 or 1 hr. rec. 35' Md BHP 68 Rng 5 1/2

DEC 5 '56 5 1/2 @ 4399/150 DEC 12 '56

CO 4377 75/4297-4309

+st 3 BW 30" 1/2 \$ 12

B Acid W 15 hrs Frac \$

39 BW 22 hrs Sqd 4297

-4309 CO 4288 25/4272-76

\$ 35 BW 17 hrs DEC 19 '56

Sqd 4272-76 CO 4273

30/4266-71 1/4 B 16 G

Acid wtr 1 hr Frac \$ 5

BW in 5 hrs PB 3955 48/

3922-30 1/2 \$ 89 BW in

11 hrs

D&A