
Stafford KANSAS

SECTION 31 TOWNSHIP 24 RANGE 11 W

WELL NO. #1 Irvine "C"

COMPANY Rex & Morris

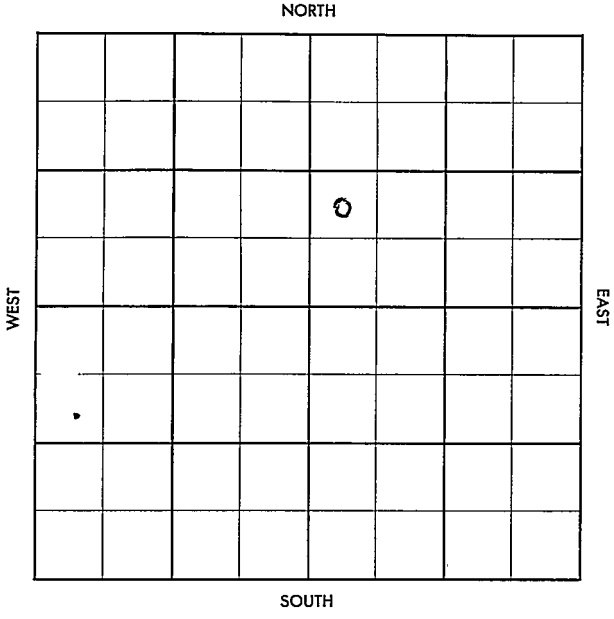

Stafford KANSAS

SEC.	TWP.	R.
31	24	11W

WELL NO.

#1 Irvine "C" FARM


COMPANY

Rex & Morris

CONTRACTOR

CRA

Wildcat

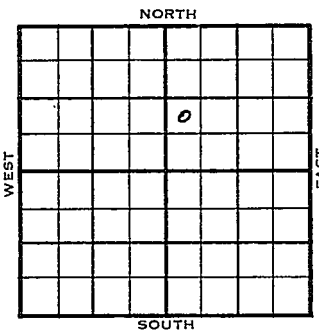

_____ Ft. from N. Line

_____ Ft. from S. Line

_____ Ft. from E. Line

_____ Ft. from W. Line

NW SW NE

1955 — ELEVATION 1834' — REPORT

11/9 R U R

11-23 Comm. 11-8-55
§ 5/8" @ 305/200
DST 3888-93 op 1 hr. gas in 24 min. rec. 60' drlg. mud, 1000/20"
DST 3893-3903 op 1 hr. rec 110' ho&gcm 90' ~~xxxxxx~~ vhocmw, 90' wtr., 1000/20"
D & A

Tops	Depth	Log
H.	3295	3292
Tr.	3310	3306
Dg.	3334	3330
B.L.	3446	3445
L.	3476	3476
BKC	3754-	3754
Ce		3763
K.	3801-	3801
V.	3886	3886
Sd	4017	4015
A	4080	4980

TD 4105'

ABANDONED

DX-78

FORM 513 REV. SUNRAY

County Stafford — Elev.

Sec. 31 — Twp. 2N — Rge. 11W

Company Rex & Morris

Farm Name Irvine "C" — No. 1


TOPS	DEPTH	LOG	DATUM
Anh.			
Tp.			
H.			
Tr.			
Dg.			
Bl.			
L.			
K.C.			
B.K.C.			
Ce.			
C.			
M.			
M.			
K.			
Mz.			
Mo.			
V.			
S.			
S.			
A			
R.			
P€.			
G.			
T.D.			

Loc. in Sec. NW SW NE

Geol.

Contr. C R A

Pool Wildcat

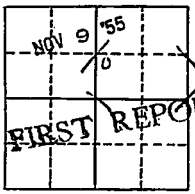

Date Comm. R U R

Co. Lse. No. Sec. T. R.

FORM 513 REV. SUNRAY

County Stafford Elev. 1834

Sec. 31 Twp. 24S Rge. 11W

Company Rex & Morris

Farm Name Irvine "C" No. 1


TOPS	DEPTH	LOG	DATUM
Anh.			
T.P.			
H.	3295	3292	1458
Tr.	3310	3306	1472
Dg.	3334	3330	1496
Bl.	3446	3445	1611
L.	3476	3476	1642
K.C.			
B.K.C.	3754	3754	1920
Ce.		3763	1929
C.			
M.			
M.			
K.	3801	3801	1967
Mz.			
Mo.			
V.	3886	3886	2052
S. Sd	4017	4015	2181
S.			
A	4080	4080	2246
R.			
Pe.			
G.			
T.D.	4105		

Loc. in Sec. NW SW NE

Geol.

Contr. C R A

Pool Wildcat

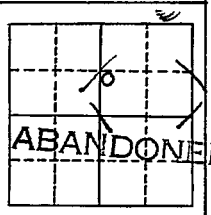

Date Comm. 11-8-55 NOV 2 3 1955

8 5/8" @ 305/200 DST 3888-93 open 1 hr gas in 24 min. rec. 60' drlg. mud 1000/20" DST 3893-3903 open 1 hr. rec. 110' ho & gcm 90' vhocmw 90' wtr. 1000/20"

D & A

Co. Lse. Sec. T. R.