

KANSAS


FORM 51 5M PETROL

Stafford

Section 31 Township 24 Range 12-W

Well No. #1 C. Kirpatrick

Company Continental

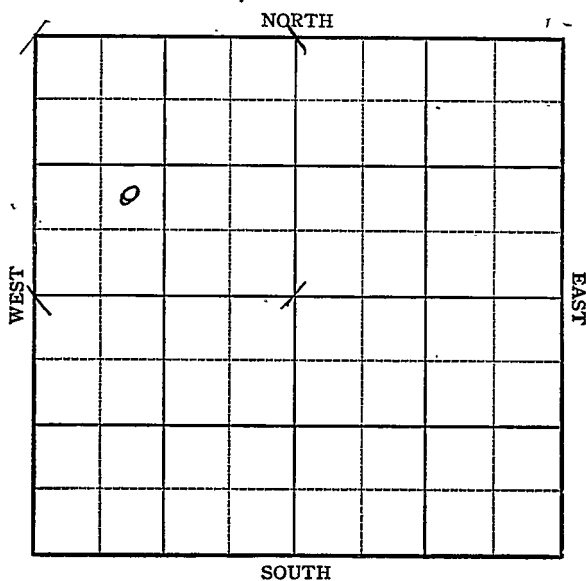

KANSAS

Sec. 31 Twp. 24 R. 12-W

Well No. #1 C. Kirkpatrick Farm


Continental Company

 Ft. from N. Line

990 Ft. from S. Line

 Ft. from E. Line

990 Ft. from W. Line

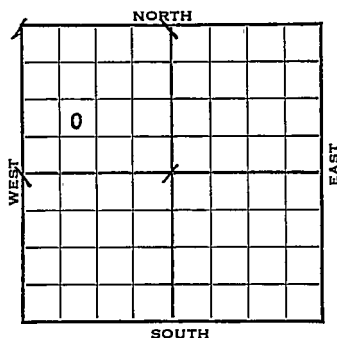

1943

Elev. 1902

REPORT

8/18

Derrick

8/25

10" @ 281
Drlg. 1335'

9/1

Drlg. 3335'

9/8

Viola 3991
Simp 4096
Arb 4160
T.D. 4175

ABANDONED

KANSAS

Map No. 47 Sec. 31 Twp. 24 R. 12WWell No. 1 C. KirkpatrickContinental

Company

FIRST REPORT


Contractor

NE SW NW

SECTION PLAT

 Ft. from N. Line990 Ft. from S. Line Ft. from E. Line990 Ft. from W. Line

WILDCAT

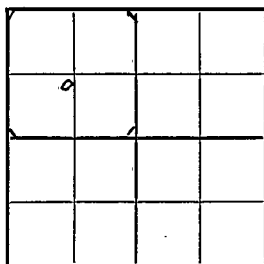Location Rig up

Drilling and Remarks:

Derri ck

RECORD

Cased in., ft.Sand Gas Oil Total Depth

PRODUCTION

1st 24 hrs. Nat. 1st 24 hrs. after shot Gas Cu. Ft.Dry Hole Abandoned

Date

AUG 18 1943 19S. J. LEWIS Scout

Stafford

KANSASMap No. 77 Sec. 31 Twp. 24 R. 12WWell No. 1 C. KirkpatrickContinental

Company

ABANDONED

Contractor

NE SW NW

 Ft. from N. Line990 Ft. from S. Line Ft. from E. Line990 Ft. from W. Line

WILDCAT

SECTION PLAT

o			

Location Rig up

Drilling and Remarks:


RECORD

Cased in., ft.Sand Gas Oil Total Depth 4175

PRODUCTION

1st 24 hrs. Nat. 1st 24 hrs. after shot Gas Cu. Ft.Dry Hole Abandoned

Date

SEP 8 1943 19S. J. LEWIS Scout