


Stafford KANSAS

DX 78-1

Section 31 Township 24 Range 11W

Well No. 1 Satterlee

Company Gulf Oil

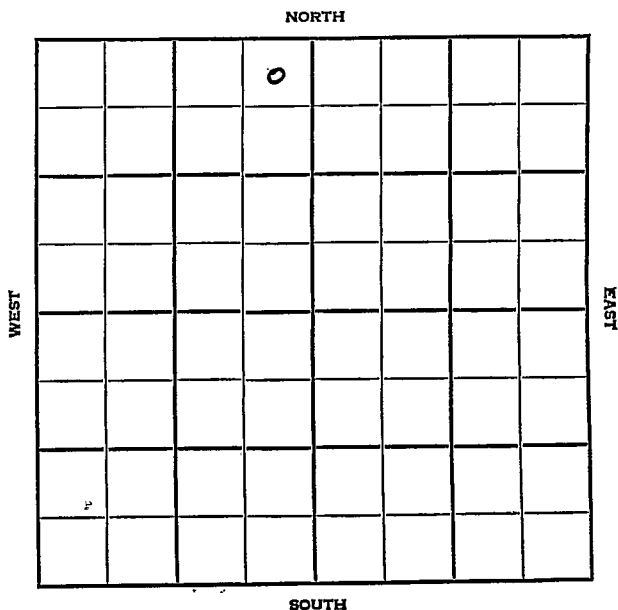

Stafford KANSAS

SEC.	31	TWP.	24	R.	14W
WELL NO.					
1 Sutterlee				FARM	
COMPANY					
Gulf Oil					
CONTRACTOR					
Garvey					
Wildcat					


330 Ft. from N. Line

Ft. from S. Line

330 Ft. from E. Line

Ft. from W. Line

NE NE NW

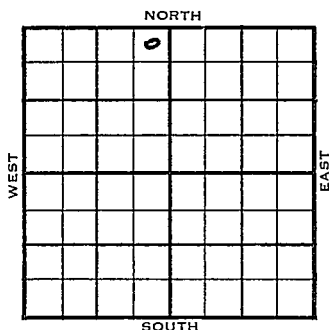

1954

ELEVATION

1995

REPORT

6/15

spdg 6-12-54

8" @ 947

Anhy 942

6/23

Heeb 3595 Tor. 3612 Doug 3639

Lans 3760

6/30

Marm 4088 Cong. H1H8 Miss Chat 4173

DST 1 4166-79

1 hr. 930 oil 150 Ho & gcm 1330#

DST 4203-10 1 hr. 15' m KH 4224

RTD 4240

5" @ 4240 log

7/7

36/4168-77 S/3 Boph 6 hrs sd-0- frac

4 163 BO 8 1/2 hrs F82 BO 6 hrs

8/4

Spud 6-12-54 Oil well TD 4240

8" @ 947 Anhy 942 Heeb 3595

Tor. 3612 Doug 3639 ~~Kans 3595~~

~~Tor. Lans. 3760' Marm. 4088'~~

Cong. 4148 Miss. 4173

DST 4166-79 open 1 hr rec 930' oil

150' HO & GCM 1330#

DST 4203-10 open 1 hr rec 15' mud


Kh. 4224 TD 4240 5" @ 4240

36/4168-77 S/3 BOPH 6 hr. sd-oil-frac

F/163 BO 8 1/2 hr. F/82 BO 6 hr.

Comp. F/4 5 BOPD

J. G. McGEHEE

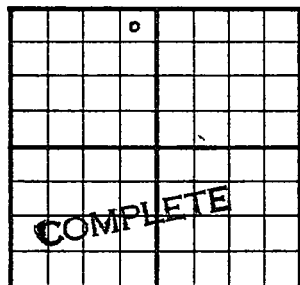County Stafford State KansasSec. 31 (Blk.
Twp.) 24 (Sur.
Rge.) 14W Map No.Operator Gulf OilWell No. 1 Farm SutterleeElev. 1995 Location NE NE NW330 Ft. From N Line NW330 Ft. From E Line Quarter1st. ReportCompletion AUG 4 1954Remarks WildcatGarvey - Contr.Spudding Date 6-12-54Drlg. Data Oil well TD 42408" @ 947 Anhy 942 Heeb. 3595Tor. 3612 Doug. 3639 Lans. 3760Marm. 4088 Cong. 4148 Miss. 4173DST 4166-79 open 1 hr. Rec. 930' oil150' ho & gcm 1330# DST 4203-10open 1 hr. Rec. 15' mud Kh. 4224TD 4240 5" @ 4240 36/ 4168-77S/ 3 boph 6 hr. sd-oil-fracF/ 163 bo 8 $\frac{1}{2}$ hr. F/ 82 bo 6 hr.Comp. F/ 45 bopd

J. G. McGEHEE