

KANSAS


Form 51-5M-7-40-Palace

Finney

Section 31 Township 24 Range 33-W

Well No. #1 Spratt

Company Kans.P.L.&Kans. Natl. Gas

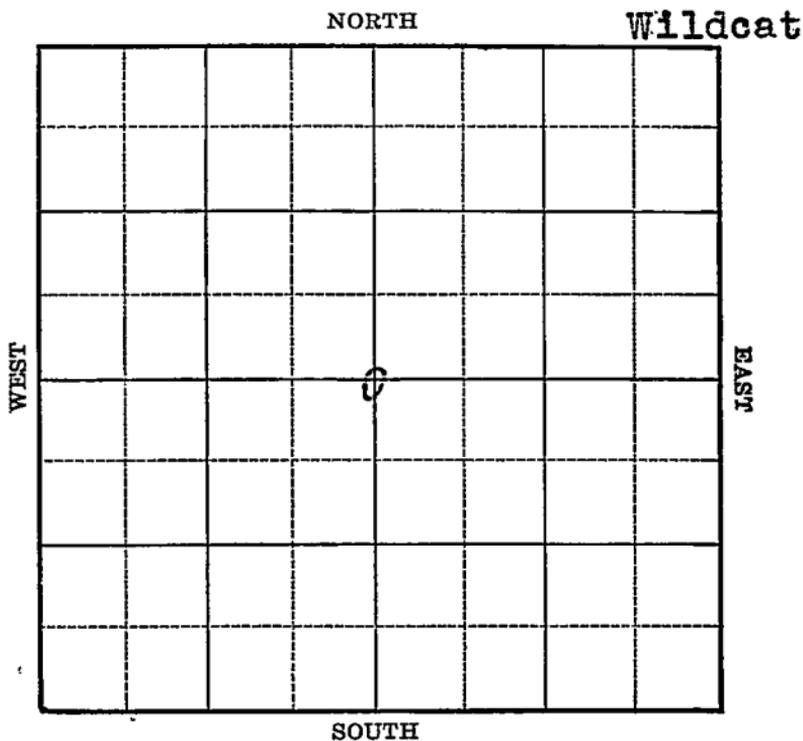

Sec. 31 Twp. 24 R. 33-W

Well No. #1 Spratt Farm _____

Kans. P.L. & Kans. Natl Gas. Company _____


(Wildcat)

2640 Ft. from N. Line

_____ Ft. from S. Line

2640 Ft. from E. Line

_____ Ft. from W. Line

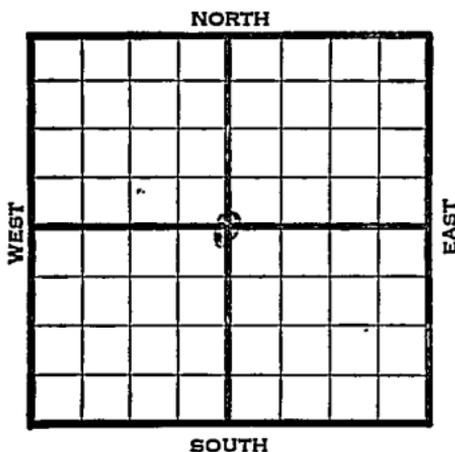

1941	REPORT
1/8	Location
1/16	"
1/23	"
1/30	10" - 560' Drlg. 2401'
2/6	7" - 2520' T.D. 2750'
2/13	8/10 M gas.
2/13	" "
2/19	Sand 2520'
	7" - 2520'
	T.D. 2763'
	14,750 acid.
	7½ M gas.
	COMPLETED

Map No. NM Sec. 31 Twp. 24 R. 33WWell No. 1 SprattKans. P. L. & Kans. Natl. Gas Company

Contractor

FIRST REPORT


C Sec.

2640 Ft. from N. Line

_____ Ft. from S. Line

2640 Ft. from E. Line

_____ Ft. from W. Line

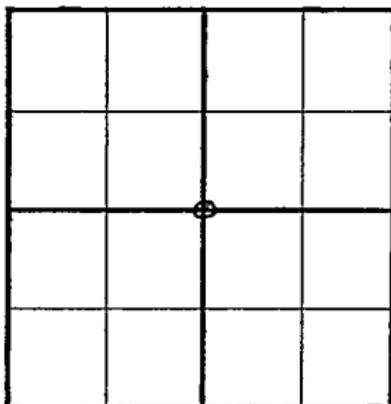SECTION PLAT

WILD CAT

Location X

Rig up _____

Drilling and Remarks:

RECORD

Cased _____ in., _____ ft.

Sand _____

Gas _____

Oil _____

Total Depth _____

PRODUCTION

1st 24 hrs. Nat. _____

1st 24 hrs. after shot _____

Gas _____ Cu. Ft.

Dry Hole _____

Abandoned _____

Date

JAN 8 1941₁₉S. J. LEWIS Scout

Map No. NM Sec. 31 Twp. 24 R. 33W

Well No. 1 Spratt

Kansas Pipe Line- Company
Kansas Nat. Gas
 Contractor

COMPLETED

C Sec.


2640 Ft. from N. Line

 Ft. from S. Line

2640 Ft. from E. Line

 Ft. from W. Line

SECTION PLAT

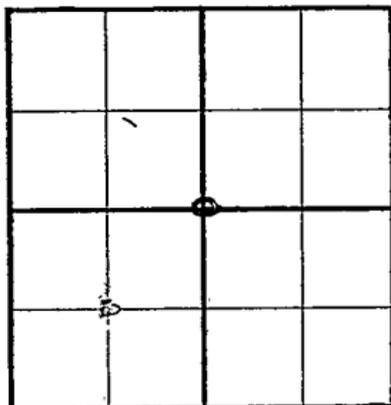

WILDCAT

Location _____

Rig up _____

Drilling and Remarks:

Sand 2520
7" @ 2520
14 750 acid
7 1/2 M Gas

RECORD

Cased _____ in., _____ ft.

Sand _____

Gas _____

Oil _____

Total Depth 2763

PRODUCTION

1st 24 hrs.-Nat. _____

1st 24 hrs. after shot _____

Gas _____ Cu. Ft.

Dry Hole _____

Abandoned _____

Date

FEB 19 1941 19

S. J. LEWIS Scout