

KANSAS


FORM 51 JOM 12-46 PETROL

Kearny county

Section 31 Township 24 Range 35-W

Well No. #1, Orr

Company Helmerich and Payne

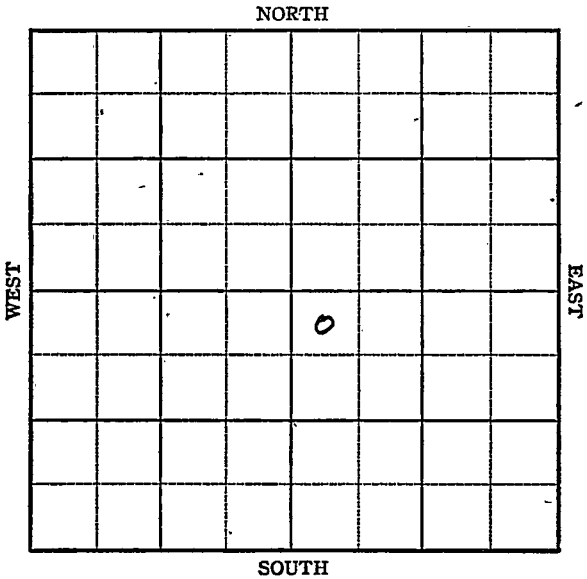

KANSAS

Kearny County

Sec. 31 Twp. 24 R. 35

Well No. 1 Orr Farm

Helmerich & Payne Company

Hugoton Pool


330 Ft. from N. Line

Ft. from S. Line

Ft. from E. Line

330 Ft. from W. Line

NORTH

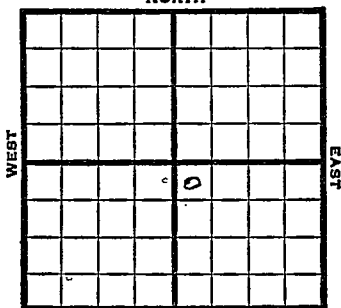

SOUTH

NW SE

1947 Elev. 2983' REPORT

1/8 Location

1/15 "

1/21 Drlg 800

1/30 10" @ 760'
Drlg 2060'

2/5 TD 2660'
7" @ 2654'
RUST

2/12 " "

2/19 " "

2/26 " "

3/4 TD 2660'

3/11 TD 2660'

3/18 SD

3/25 "

4/2 "

4/9 "

OVER

4/15 SD

4/23 20,000 acid

4/29 " "

5/7 " "

5/14 7" @ 2654'
Perf.
22,000 Acid
25,938,000 Gas
389# R. Pr.
TD 2660'

COMPLETED

Map No. _____ Sec. 31 Twp. 24 R. 35W

Well No. 1 Orr

Helmerich & Payne Company

FIRST REPORT Contractor

NW SE

SECTION PLAT

330 Ft. from N. Line

_____ Ft. from S. Line

_____ Ft. from E. Line

330 Ft. from W. Line

		o	

Kearny County

Location X

Rig up

Drilling and Remarks:

RECORD

Cased _____ in, _____ ft.

Sand _____

Gas _____

Oil _____

Total Depth _____

PRODUCTION

1st 24 hrs. Nat. _____

1st 24 hrs. after shot _____

Gas _____ Cu. Ft.

Dry Hole _____

Abandoned _____

Date

JAN 8 1947 19

S. J. LEWIS Scout

Map No. _____ Sec. 31 Twp. 24 R. 35W

Well No. 1 Orr

Helmerich & Payne etal. Company

COMPLETE

Contractor

NW SE

E 12983
SECTION PLAT

330 Ft. from N. Line

_____ Ft. from S. Line

_____ Ft. from E. Line

330 Ft. from W. Line

		8	

Kearny County

Location _____

Rig up _____

Drilling and Remarks:

7" @ 2654

Prof.
22000 acid
20,938,000 Gas
389 R 1/2

RECORD

Cased _____ in., _____ ft.

Sand _____

Gas _____

Oil _____

Total Depth 2660

PRODUCTION

1st 24 hrs. Nat. _____

1st 24 hrs. after shot _____

Gas _____ Cu. Ft.

Dry Hole _____

Abandoned _____

Date

MAY 14 1947

19

S. J. LEWIS

Scout