

Finney

KANSAS

SEC. 16-	TWP. 24S	R. 32W
----------	----------	--------

WELL NO.

#1 Mayo Gas Unit "B"

COMPANY

Stanolind

CONTRACTOR

Barbour

Hugoton

Ft. from N. Line

1250'


Ft. from S. Line

Ft. from E. Line

20

Ft. from W. Line

NW SW NE

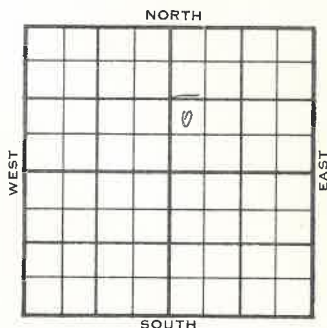

1955

ELEVATION
2830' RB
2827' DF

REPORT

9-21

Comm. 9-1-55

8 5/8" @ 927 w/500

5 1/2" @ 2592;

CO 2577; 16/2552-56; 36/2563-72; frac;

PB 2536; 20/2503-08; 24/2510-16;

24/2518-24; 8/2531-33; frac;

PB 2575; 12,237,000 cfg.

SIP 390# 20"

Tops: Herr 2500

Kri. 2530

Winf. 2562

T.D. 2594'

FIRST REPORT

COMPLETED

DX-78

DX 78-1


Finney

KANSAS

Section 16 Township 24 Range 32 W

Well No. #1 Mayo Gas Unit "B"

Company Stanolind

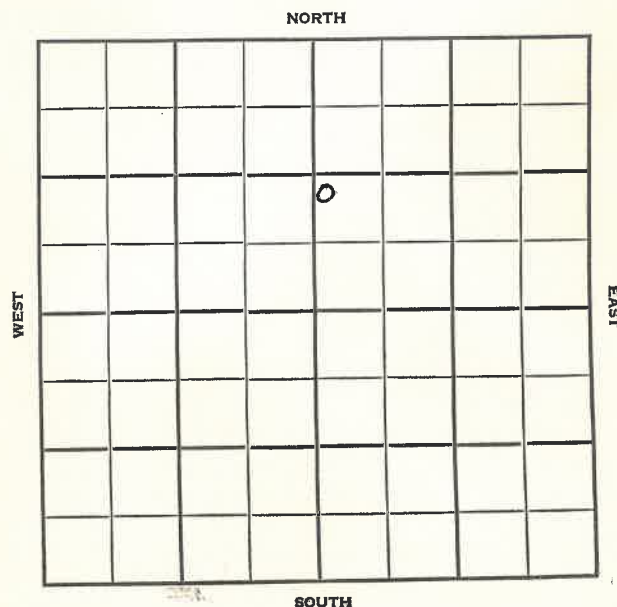

County Finney Elev. 2830 RB
 Sec. 16 Twp. 24 Rge. 32W
 Company Stanolind
 FarmName Mayo Gas Unit "B" No. 1

TOPS	DEPTH	LOG	DATUM	Loc. in Sec.
Anh.				NW SW NE
T.P.				1250' SL
H.				20' WL
Tr.				
Dg.				
Bl.				
L.				
K.C.				Geol.
B.K.C.				Contr.
Ce.				Barbour
C.				
M.				Pool
K.				Hugoton
Mz.				
Me.				
V.				
S.				
A.				
R.				
Pe.				
G.				
T.D.				

Date Comm. 9-1-55

drlg. 6/45

SEP 1 1955
FIRST REPORT

County Finney Elev. 2830 RB
 Sec. 16 Twp. 24S Rge. 32W
 Company Stanolind
 FarmName Mayo Gas Unit "B" No. 1

TOPS	DEPTH	LOG	DATUM	Loc. in Sec.
Anh.				NW SW NE
T.P.	2500			1250' SL
H.	2530			20' WL
Tr.				
Dg.	2562			
Bl.				
L.				
K.C.				Geol.
B.K.C.				Contr.
Ce.				Barbour
C.				
M.				Pool
K.				Hugoton
Mz.				
Me.				
V.				
S.				
A.				
R.				
Pe.				
G.				
T.D.	2594			

Date Comm. 9-1-55

SEP 2 1 1955

8-5/8" 927 w/500; 5 1/2" 2592; CO 2577; 16/
 2552-56; 36/2563-72; frac; PB 2536;
 20/2503-08; 24/2510-16; 24/2518-24;
 8/2531-33; frac; PB 2575; 12,237,000 cfb
 SIP 390# 20"

FIRST REPORT

COMPLETE