


Map No. **KANSAS** Sec. **32** Twp. **24** R. **4W**

Well No. **1 Popp** Farm
Mc Brien et al Company

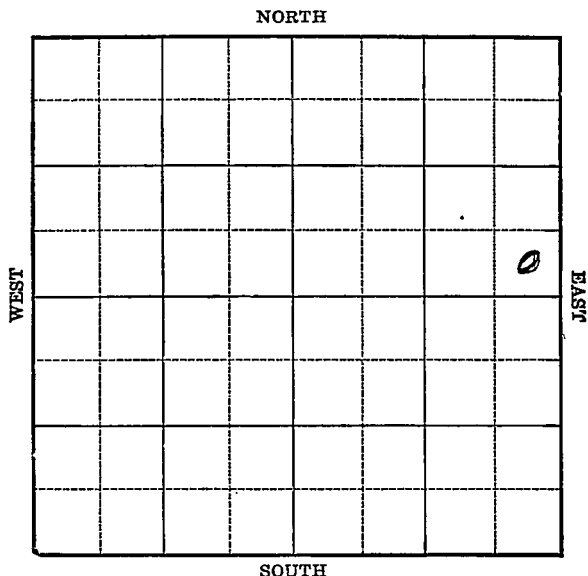

Location _____

Drilling Remarks _____

Rig Up _____

Drilling Remarks _____

RECORD

Cased _____ in. _____ ft.

Sand _____

Gas _____

Oil _____

Total Depth _____

PRODUCTION

1st 24 hrs. Nat. _____

1st 24 hrs. after shot _____

Gas _____ cu. ft.

Dry Hole _____

Abandoned _____

Reno

Map No. KANSAS Sec. 32 Twp. 24 R. 4^W
Well No. 1 Papp Farm
Mc Bride et al Company

NORTH

WEST

EAST

SOUTH

Ft. from N. Line

330 Ft. from S. Line

330 Ft. from E. Line

Ft. from W. Line

Date

REPORT

9/19 Location
9/26 Bldg. Rot. Rig
10/4 15" 248 WOC
10/11 Bldg 1715
10/18 " 2755 Lansing 2685
10/25 3277 feg
11/1 Chert 3410 8" 3422 TD 3425
Rust
11/8 5.0. 3438-43 at 3492 2000'
water Bldg 3499
11/15 3630 3000' Water
11/22 6" 3645 13' ML 3672
Hutton 3768 3775 2500' Water
11/28 Bldg 3820 6" 3787
12/6 Viola 3870 Wilcox 3879
3882 HFW 5D
12/13 12/21—
12/26 Viola 3870 TD 3882 Drft

ABANDONED

Map No. 40 Sec. 32 Twp. 24 R. 4WWell No. 1-PappMcBride et al Company

Contractor

SECTION PLAT

 Ft. from N. Line330 Ft. from S. Line330 Ft. from E. Line Ft. from W. Line

FIRST REPORTS

Location ✓Rig up

Drilling and Remarks:

RECORD

Cased in., ft.Sand Gas Oil Total Depth

PRODUCTION

1st 24 hrs. Nat. 1st 24 hrs. after shot Gas Cu. Ft.Dry Hole Abandoned

Date

9-19-37 19

ORVAL MANNSCHRECK

Scout

KANSAS

Map No. 40 Sec. 32 Twp. 24 R. 4WWell No. 1-PappMcBride et al Company

Contractor

ABANDONED

SECTION PLAT

Ft. from N. Line

330 Ft. from S. Line330 Ft. from E. Line

Ft. from W. Line

			0

Location

Rig up

Drilling and Remarks:

N V A

RECORD

Cased in., ft.

Sand Viola 3870

Gas

Oil

Total Depth 3882

PRODUCTION

1st 24 hrs. Nat.

1st 24 hrs. after shot

Gas Cu. Ft.

Dry Hole

Abandoned

Date

12-26-34 192

ORVAL MANNSCHRECK

Scout