


Kearny

Section 32 Township 24 Range 27-WWell No. #1 TateCompany Kansas Oil & Gas Prod

NORTH

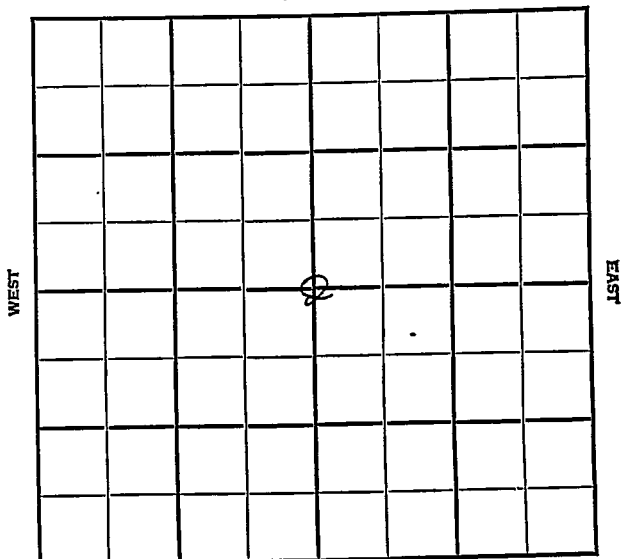

SOUTH

Kearny

Sec. 32 **KANSAS** Twp. 24 R. 27W ✓

Well No. #1 Tate Farm _____
Kansas Oil & Gas Prod. Company _____


Hugoton
2640' Ft. from N. Line

_____ Ft. from S. Line

2640' Ft. from E. Line

_____ Ft. from W. Line

C Sec.

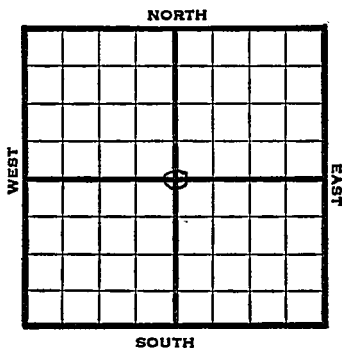

1948	REPORT
	Eli 3241'
7/14	Dr1g. 2580'
7/21	10" @ 700'
	TD 2771'
	7" @ 2770'
7/28	"
8/4	"
8/11	"
8/18	"
8/25	"
9/1	"
9/8	"
9/14	"
9/21	"
9/29	"
10/6	"
10/13	"
10/19	"
10/26	"
11/3	"
11/10	70,000 acid
11/16	"
11/23	"
11/30	"
12/6	"

OVER

1948

12/15

TD 2776'

7" @ 2770'

20000 acid

799,000 Gas

369# R pr.

Comp

COMPLETED

Map No. _____ Sec. 32 Twp. 24 R. 27WWell No. 1 Tate

Kansas Oil & Gas Prod. _____ Company

FIRST REPORT

Contractor _____

C Sec,


SECTION PLAT

2640 Ft. from N. Line

_____ Ft. from S. Line

2640 Ft. from E. Line

_____ Ft. from W. Line

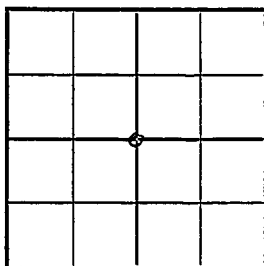

Kearny County

Location _____

Rig up _____

Drilling and Remarks:

Dr1g. 2580

RECORD

Cased _____ in., _____ ft.

Sand _____

Gas _____

Oil _____

Total Depth _____

PRODUCTION

1st 24 hrs. Nat. _____

1st 24 hrs. after shot _____

Gas _____ Cu. Ft.

Dry Hole _____

Abandoned _____

Date

JUL 14 1948

19

S. J. LEWIS Scout

Map No. _____ Sec. 32 Twp. 24 R. 37W

Well No. 1 Tate

_____ Kansas Oil & Gas Prod. _____ Company

COMPLETE

_____ Contractor

C SEC.


E13241
SECTION PLAT

2640 Ft. from N. Line

_____ Ft. from S. Line

2640 Ft. from E. Line

_____ Ft. from W. Line

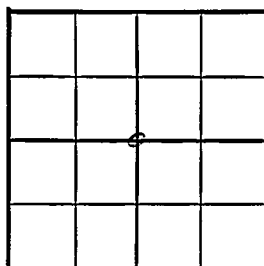

Kearny County

Location _____

Rig up _____

Drilling and Remarks:

7" @ 2770

20000 cu ft

779,000 gal

•

8692 R/R

RECORD

Cased _____ in., _____ ft.

Sand _____

Gas _____

Oil _____

Total Depth 2771

PRODUCTION

1st 24 hrs. Nat. _____

1st 24 hrs. after shot _____

Gas _____ Cu. Ft.

Dry Hole _____

Abandoned _____

Date

DEC 15 1948

19

S. I. LEWIS Scout