


KANSAS

Section 32 Township 24 Range 34W

Well No. 6 Hamlin

Company Kansas Natural Gas Co.

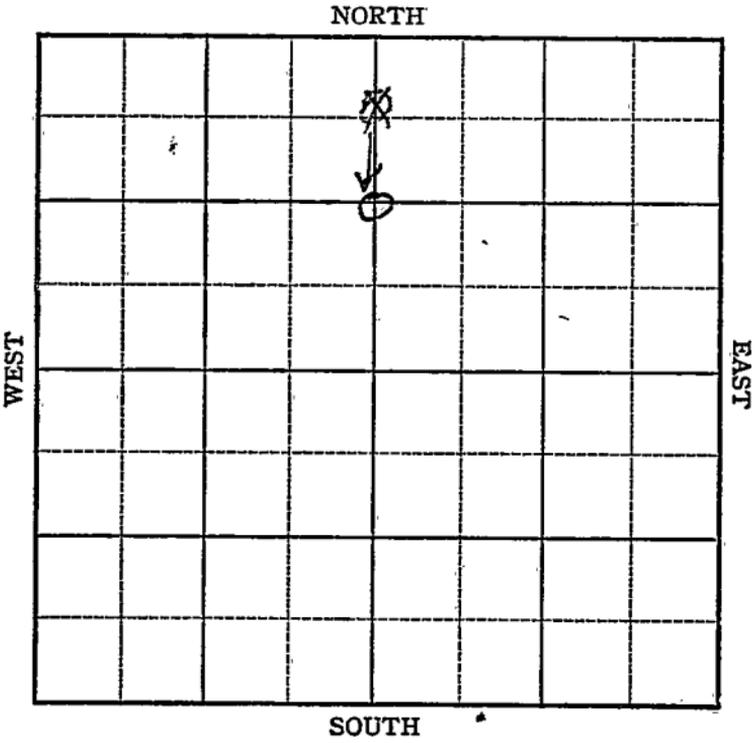

Sec. 32 Twp. 24 R. 34-W

Well No. #6 Hamlin Farm \_\_\_\_\_

Kansas Natural Gas Company

Hugoton Pool


~~300~~  
1320 Ft. from N. Line

\_\_\_\_\_ Ft. from S. Line

2640 Ft. from E. Line

\_\_\_\_\_ Ft. from W. Line

~~C-N-L~~ Sec. C N $\frac{1}{2}$  Sec.

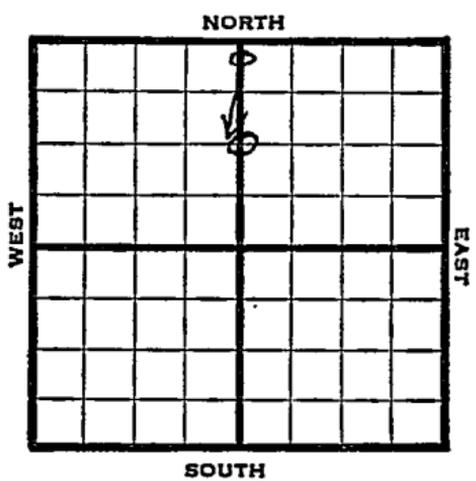

1947 El. 2978' REPORT

6/18 Drlg. 200'

6/24 10" @ 535'  
TD 2680'

7/1 7" @ 2685'  
RUST

7/9 Drlg. 2597'

7/16 "

7/22 "

7/29 "

8/6 "

8/13 7" @ 2675'  
Perf.  
55,000 acid.  
22,500,000 Gas.  
R. Pr. 385#  
T.D. 2680'  
Complete

COMPLETED

Map No. \_\_\_\_\_ Sec. 32 Twp. 24 R. 34W

Well No. 6 Hamlin


Kansas Natural Gas Company

**FIRST REPORT** Contractor

C N L 586.

**SECTION PLAT**

300 Ft. from N. Line  
\_\_\_\_\_ Ft. from S. Line  
2640 Ft. from E. Line  
\_\_\_\_\_ Ft. from W. Line

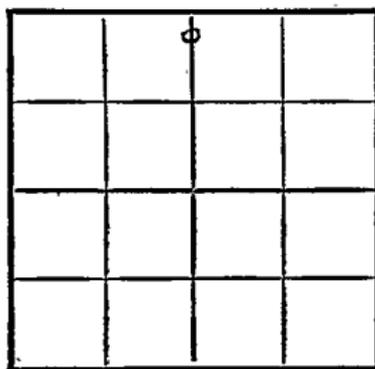

Finney County

Location \_\_\_\_\_

Rig up \_\_\_\_\_

Drilling and Remarks:

drlg. 200'

**RECORD**

Cased \_\_\_\_\_ in., \_\_\_\_\_ ft.

Sand \_\_\_\_\_

Gas \_\_\_\_\_

Oil \_\_\_\_\_

Total Depth \_\_\_\_\_

**PRODUCTION**

1st 24 hrs. Nat. \_\_\_\_\_

1st 24 hrs. after shot \_\_\_\_\_

Gas \_\_\_\_\_ Cu. Ft.

Dry Hole \_\_\_\_\_

Abandoned \_\_\_\_\_

Date

JUN 18 1947

19

S. J. LEWIS Scout

Map No. 0 Sec. 32 Twp. 24 R. 34W

Well No. 6 Hamlin

Kansas Natural Gas Company

CORRECTION Contractor

C N  $\frac{1}{2}$  Sec.

1320 Ft. from N. Line

         Ft. from S. Line

2640 Ft. from E. Line

         Ft. from W. Line

SECTION PLAT


Finney County

Location         

Rig up         

Drilling and Remarks:

Reported

C N L Sec.

RECORD

Cased          in.,          ft.

Sand         

Gas         

Oil         

Total Depth         

PRODUCTION

1st 24 hrs. Nat.         

1st 24 hrs. after shot         

Gas          Cu. Ft.

Dry Hole         

Abandoned         

Date

JUL 2 1947

19

S. J. LEWIS Scout

