


KANSAS

Stafford

Section 33 Township 24 Range 15W

Well No. #2 Arch

Company Phillips

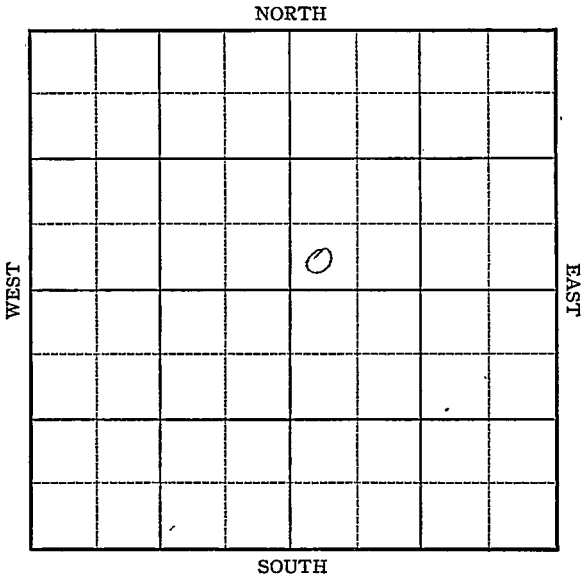

KANSAS

Sec. 33 Twp. 24 R. 15W

Well No. #2 Arch Farm

Phillips Company

Farmington


NORTH

_____ Ft. from N. Line

330 Ft. from S. Line

_____ Ft. from E. Line

330 Ft. from W. Line

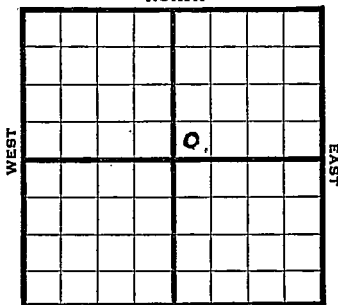

SW NE

E. 1/4 Sec. 2037

SOUTH

1944

REPORT

8/16

Drk.

8/23

"

8/30

8" @ 992

Anhy 975

Drlg. 2250

9/8

Drlg. 3708

9/13

Lans 3779

Miss 4184

Simp Sd 4432

Arb 4435

Sat TD 4438 Bun. csg.

9/21

5" @ 4439

Arb 4439 corrected

9/28

TD 4442 RUST

675 acid swb 12 oil plus 16. wtr - 12hr

10/4

Drlg. 4485

3200' wtr.

10/11

Drlg. 4612

10/18

TD 4632 SD

10/25

" " "

11/1

" " "

11/8

Impact 60 wtr per hr.

11/15

Arb. 4439

5" @ 4439

600 acid

TD 4632'

SWD

ABANDONED

KANSAS

Pool Name Farmington

Map No. 83 Sec. 33 Twp. 24 R. 15W

Well No. 2 Arch

Phillips Company

FIRST REPORT

Contractor

SW NE

SECTION PLAT

		o	

_____ Ft. from N. Line

330

_____ Ft. from S. Line

_____ Ft. from E. Line

330

_____ Ft. from W. Line

Stafford County

Location _____

Rig up _____

Drilling and Remarks:

Derrick

RECORD

Cased _____ in., _____ ft.

Sand _____

Gas _____

Oil _____

Total Depth _____

PRODUCTION

1st 24 hrs. Nat. _____

1st 24 hrs. after shot _____

Gas _____ Cu. Ft.

Dry Hole _____

Abandoned _____

Date

AUG 16 1944 19

S. J. LEWIS Scout

Pool Name FarmingtonMap No. 83 Sec. 33 Twp. 24 R. 15 WWell No. 2 ArchPhillips CompanyABANDONED Contractor

SW NE

SECTION PLAT ✓

 Ft. from N. Line330 Ft. from S. Line Ft. from E. Line330 Ft. from W. Line

Stafford CountyLocation Rig up

Drilling and Remarks:

Cor 44395" @ 4439600 acidSWD

RECORD

Cased in., ft.Sand Gas Oil Total Depth 46.32

PRODUCTION

1st 24 hrs. Nat. 1st 24 hrs. after shot Gas Cu. Ft.Dry Hole Abandoned

Date

NOV 15 194419S. J. LEWIS Scout