


Section 33 Township 24 Range 15-W

Well No. #1 Campbell

Company Bay Petroleum et al

(Wildcat)

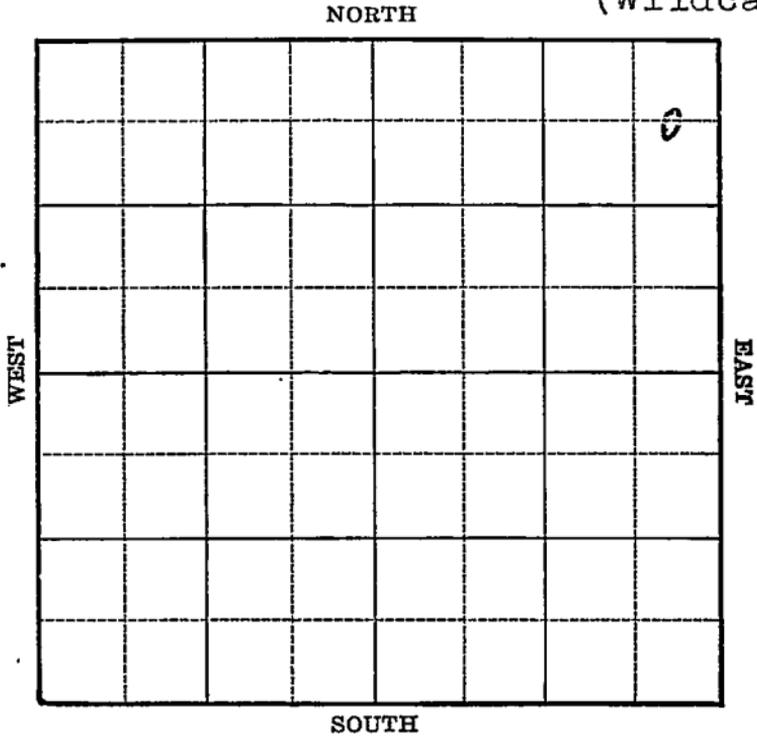

Sec. 33 Twp. 24 R. 15 -W

Well No. #1 Campbell Farm

Bay Petr. et al Company

(Wildcat)


660 Ft. from N. Line

_____ Ft. from S. Line

330 Ft. from E. Line

_____ Ft. from W. Line

Elev. 2037

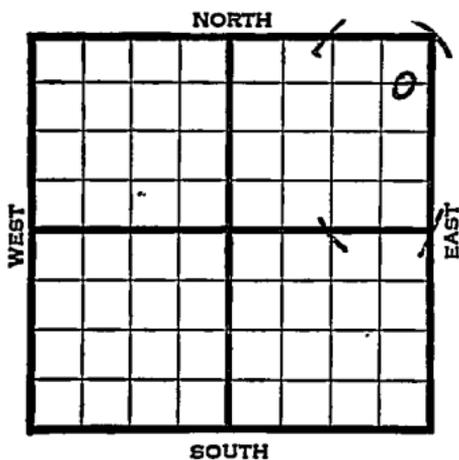

1940.	REPORT
12/18	Cellar.
12/26	13" - 212' WOC.
1941	
1/2	Anhy 1015' Drlg. 3115'
1/9	Lansing 3771' Cong. 4230' Drlg. 4330'
1/15	Arb. 4516' Viola 4324' T.D. 4570' No shows.
	ABANDONED

Map No. 83 Sec. 33 Twp. 24 R. 15W

Well No. 1 Campbell

Bay Petroleum etal Company

Contractor

FIRST REPORT

C E L N E N E

660 Ft. from N. Line

_____ Ft. from S. Line

330 Ft. from E. Line

_____ Ft. from W. Line

SECTION PLAT

WILDCAT

Location _____

Rig up _____

Drilling and Remarks:

Cellar

RECORD

Cased _____ in., _____ ft.

Sand _____

Gas _____

Oil _____

Total Depth _____

PRODUCTION

1st 24 hrs. Nat. _____

1st 24 hrs. after shot _____

Gas _____ Cu. Ft.

Dry Hole _____

Abandoned _____

Date

DEC 18 1940 19

S. J. LEWIS Scout

Map No. 83 Sec. 33 Twp. 24 R. 15WWell No. 1 CampbellBay Petroleum etal Company

Contractor

ABANDONED**SECTION PLAT**C E L N E N E
660 Ft. from N. Line

_____ Ft. from S. Line

330 Ft. from E. Line

_____ Ft. from W. Line

WILDCAT

Location _____

Rig up _____

Drilling and Remarks:


Cased _____ in., _____ ft.

Sand _____

Gas _____

Oil _____

Total Depth 4570**PRODUCTION**

1st 24 hrs. Nat. _____

1st 24 hrs. after shot _____

Gas _____ Cu. Ft.

Dry Hole _____

Abandoned _____

Date

JAN 15 1949S. J. LEWIS Scout