


Stafford

Section 33 Township 24 Range 15W

Well No. #2 Campbell

Company Stanolind

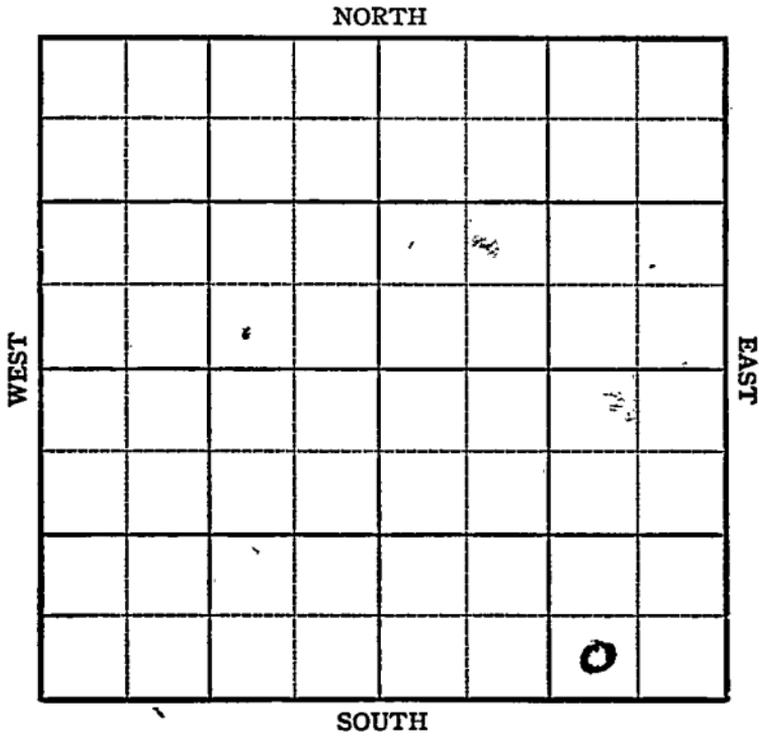

KANSAS

Stafford

Sec. 33 Twp. 24 R. 15-W

Well No. #2 Campbell Farm


Stanolind Company

_____ Ft. from N. Line

330 Ft. from S. Line

990 Ft. from E. Line

_____ Ft. from W. Line

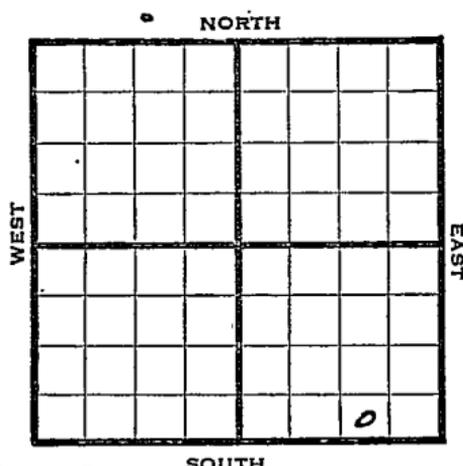

Farmington *Elev. 2044*

1944

REPORT

- 3/15 Rotary
- 3/22 13" @ 248
Drlg. 2110
- 3/29 Drlg. 3328
- 4/5 Anhy 995
Lans 3800
Drlg. 3850
- 4/12 Viola 4336
Drlg. 4350
- 4/19 Simp 4403
Arb 4477
TD 4525

ABANDONED

Map No. 83 Sec. 33 Twp. 24 R. 15W

Well No. 2 Campbell

Stanolind Company

FIRST REPORT

Contractor

SW SE SE

SECTION PLAT

Ft. from N. Line

330 Ft. from S. Line

990 Ft. from E. Line

Ft. from W. Line

Farmington Pool

Location _____

Rig up _____

Drilling and Remarks:

Rotary

RECORD

Cased _____ in., _____ ft.

Sand _____

Gas _____

Oil _____

Total Depth _____

PRODUCTION

1st 24 hrs. Nat. _____

1st 24 hrs. after shot _____

Gas _____ Cu. Ft.

Dry Hole _____

Abandoned _____

Date

MAR 15 1944 19

S. J. LEWIS Scout

