


O.W.W.O.

Section 33 Township 24 Range 15W

Well No. #1 Archie Campbell

Company Stanolind

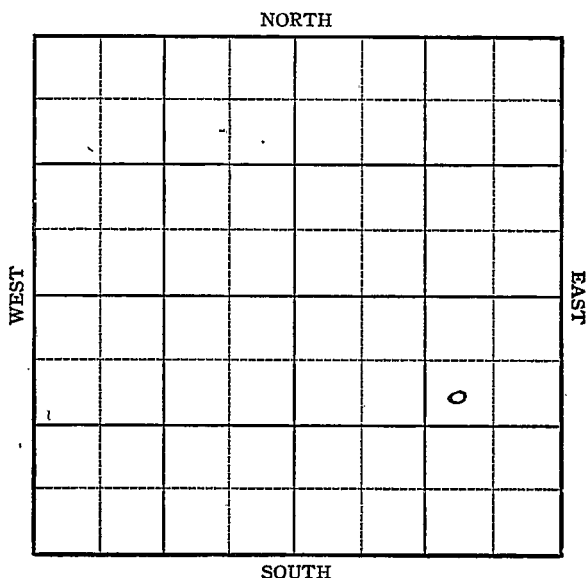

KANSAS

Stafford

Sec. 33 Twp. 24 R. 15-W

Well No. #1 Archie Campbell Farm

Stanolind

Company

SW NE SE


990 Ft. from N. Line

 Ft. from S. Line

990 Ft. from E. Line

 Ft. from W. Line

Elev. 2035

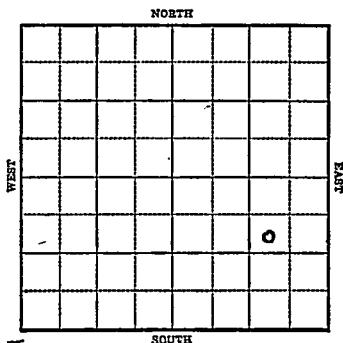

1944

R E P O R T

1/26 Location.

2/2 Rotary

2/8 @ 2713" @ 270.
WOC.

2/15 Drlg. 2792

2/23 " "

3/1 ~~1944~~ 2792
~~1944~~ 3770
Drlg. 4252

3/8 Cong. 4150
Viola 4245
Simp. 4346
Arb 4423-40 TD
5" @ 4424
RUST

3/16 23000 in Oil 475

3/22 1" 236"

3/29 " 230"

4/5 2 "

4/12 3000 acid

OVER

1944
4/19

5" @ 4424
Arb 4423
TD 4440
3000 acid
Depth Pot 8026
Max 3000
Gravity 34.8

COMPLETED

1953
12/9

O.W.W.O.

Oil well TD 4440' OTD 4440'
5" @ ~~4424~~ 4424' Lans. 3760'
Kh. 4150' Viola 4213' Simp. 4342'
Arb. 4411' PB 3954' 50/3930-40
1000 A 72 BOPD 5,500,000 CFG
Comp. 4½ BOPH 5,500,000 CFGPD

FIRST REPORT



COMPLETED

KANSAS

Map No. 83 Sec. 33 Twp. 24 R. 15WWell No. 1 Archie Campbell

Stanolind

Company

FIRST REPORT

Contractor

SW NE SE

SECTION PLAT

990


Ft. from N. Line

Ft. from S. Line

990

Ft. from E. Line

Ft. from W. Line

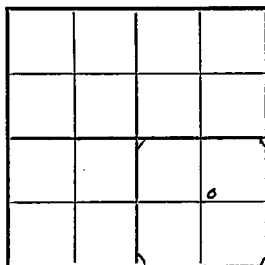

Farmington Pool

Location X

Rig up

Drilling and Remarks:

RECORD

Cased _____ in., _____ ft.

Sand _____

Gas _____

Oil _____

Total Depth _____

PRODUCTION

1st 24 hrs. Nat. _____

1st 24 hrs. after shot _____

Gas _____ Cu. Ft.

Dry Hole _____

Abandoned _____

Date

JAN 26 1944

19

S. J. LEWIS Scout

Pool Name Farmington

KANSAS

Map No. 3 Sec. 33 Twp. 24 R. 15WWell No. 1 Archie CampbellStanolind


Company

COMPLETED

Contractor

SW NE SE

SECTION PLAT

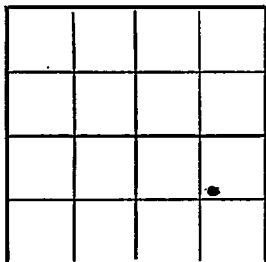990 Ft. from N. Line

Ft. from S. Line

990 Ft. from E. Line

Ft. from W. Line

Stafford County

RECORD

Location _____

Cased _____ in., _____ ft.

Rig up _____

Sand _____

Drilling and Remarks:

Gas _____

Oil _____

Total Depth 4450

PRODUCTION

1st 24 hrs. Nat. _____

1st 24 hrs. after shot _____

Gas _____ Cu. Ft.

Dry Hole _____

Abandoned _____

Date

APR 1 9 1944 19S. J. LEWIS Scout

O.W.W.O.

County Stafford State Kansas
 Sec. 33 (Blk. 24) (Sur. 15W) Map No. 15W
 Operator Stanolind
 Well No. 1 Farm A. L. Campbell
 Elev. Location SW NE SE

FIRST REPORT
COMPLETE

990 Ft. From N Line SE
 990 Ft. From E Line Quarter
 Ist. Report DEC 9 1953
 Completion DEC 9 1953
 Remarks OWWO

O.W.W.O.

Spudding Date Drig. Data Oil well TD 4440OTD 4440 5" @ 4424 Lens. 3760Kh. 4150 Viola 4213 Simp. 4342Arb. 4411 PB 3954 50/ 3930-40 1000 A72 bopd 5,500,000 cfgComp. 4½ boph 5,500,000 cfgpd

J. G. McGEHEE