

KANSAS

Finney

Section 33 Township 24 Range 34W

Well No. 21 Brown


Company Northern Natural Gas

Hugoton

NORTH

WEST

EAST

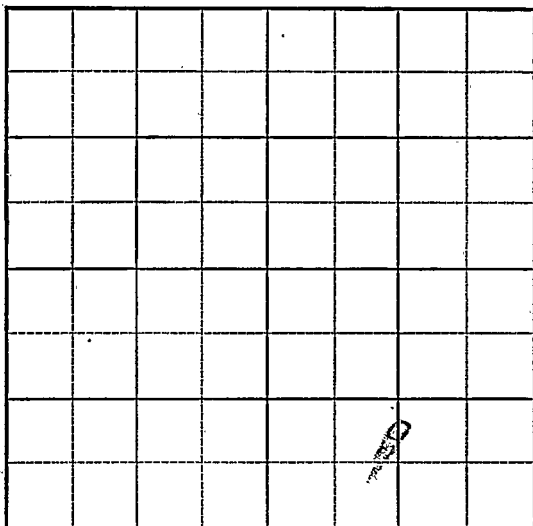

SOUTH

Finney

KANSAS

Sec. 33 Twp. 24 R. 34W

Well No. #21 Brown Farm

Northern Natural Gas Company
Hugoton Pool (Moran Drlg, Cont_{NORTH})

 Ft. from N. Line

990'


 Ft. from S. Line

1320'

 Ft. from E. Line

 Ft. from W. Line

C N L S $\frac{1}{2}$ SE

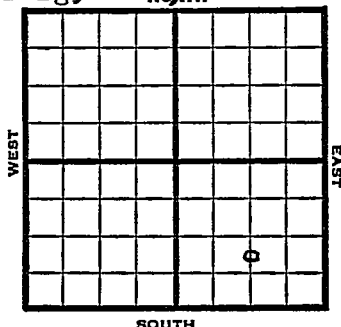

1949 Elev 2988' REPORT

7/20 Drlg. 250'

7/27 10" @ 393'

TD 2500'

7" @ 2485'

8/3 Drlg. 2565'

8/10 225' of 5" liner @ 2702'

TD 2702'

8/17 "

"

8/24 "

"

8/31 "

9/7 "

"

9/14 "

9/21 "

9/28 TD 2702'

7" @ 2485'

225' of 5" Perf Liner @ 2702'

20000 acid

13,632,000 Gas

435# R Pr.

Comp

COMPLETED

Map No. _____ Sec. 33 Twp. 24 R. 34W

Well No. 21 Brown

Northern Natural Gas Company

Moran Drle. Contractor

C NLS $\frac{1}{2}$ SE


FIRST REPORT
SECTION PLAT

_____ Ft. from N. Line

990 Ft. from S. Line

1320 Ft. from E. Line

_____ Ft. from W. Line

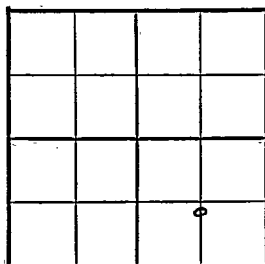

Finney County

Location _____

Rig up _____

Drilling and Remarks:

drlg. 250

RECORD

Cased _____ in., _____ ft.

Sand _____

Gas _____

Oil _____

Total Depth _____

PRODUCTION

1st 24 hrs. Nat. _____

1st 24 hrs. after shot _____

Gas _____ Cu. Ft.

Dry Hole _____

Abandoned _____

Date

JUL 20 1949 19

S. J. LEWIS Scout

Map No. _____ Sec. 33 Twp. 24 R. 34W

Well No. 21 Brown

Northern Natural Gas Company

COMPLETE

Contractor

C N L $S\frac{1}{2}$ SE


E 12988
SECTION PLAT

_____ Ft. from N. Line

990 Ft. from S. Line

1320 Ft. from E. Line

_____ Ft. from W. Line

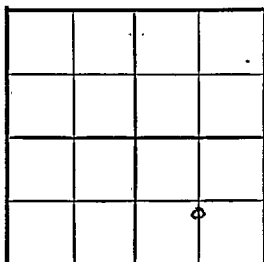

Finney County

Location _____

Rig up _____

Drilling and Remarks:

7 "C 2485"
225 3/4" Perf line
C 2702
20000 acid
18,632,000 Gal
*H. 25 * R. A*

RECORD

Cased _____ in., _____ ft.

Sand _____

Gas _____

Oil _____

Total Depth 2702

PRODUCTION

1st 24-hrs. Nat. _____

1st 24 hrs. after shot _____

Gas _____ Cu. Ft.

Dry Hole _____

Abandoned _____

Date

SEP 28 1949

19

S. J. LEWIS

Scout