


Map No. **KANSAS** Sec. **34** Twp. **24** R. **5W** *Reno*
 Well No. *Mc Miller* Farm
Mc Pherson Company

NORTH

WEST

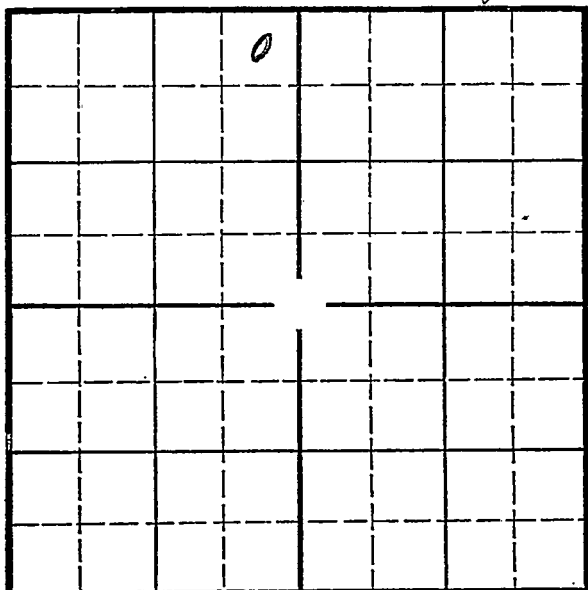

SOUTH

Location _____

Drilling Remarks _____

Rig Up _____

Drilling Remarks _____

RECORD

Cased _____ in. _____ ft.

Sand _____

Gas _____

Oil _____

Total Depth _____

PRODUCTION

1st 24 hrs. Nat. _____

1st 24 hrs. after shot _____

Gas _____ cu. ft. _____

Dry Hole _____

Abandoned _____

Map No. KANSAS Sec. 34 Twp. 24 R. 5W
Well No. 1- Miller Farm
Mc Pherson Bldg Company


330 Ft. from N. Line

 Ft. from S. Line

330 Ft. from E. Line

 Ft. from W. Line

Elev. 1543

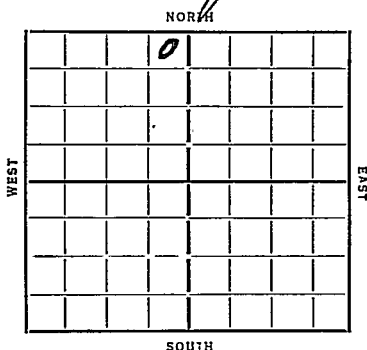

Date	REPORT
1935	
8/21	Bldg
8/29	Rch 15 1/2 225
9/6	Bldg 400 12" 505
9/14	" 1565
10/3	TC 3402 8" 3402
	3452 T7 17m. Sec.
10/10	T7 3479 5. Hbls per hr
	1/2 Water
10/24	TC 3402
	TD 3501
	2000 acib
	176 Oil
	40 Water

COMPLETED

KANSAS

Map No. 40 Sec. 34 Twp. 24 R. 5WWell No. 1-MillerMcPherson Company

Contractor

FIRST REPORTS

SECTION PLAT

330 Ft. from N. Line

Ft. from S. Line

330 Ft. from E. Line

Ft. from W. Line

	0		

Location

Rig up

Drilling and Remarks:

Bldg

RECORD

Cased.....in.,ft.

Sand.....

Gas.....

Oil.....

Total Depth.....

PRODUCTION *

1st 24 hrs. Nat.....

1st 24 hrs. after shot.....

Gas.....Cu. Ft.

Dry Hole.....

Abandoned.....

Date

ORVAL MANSCHRECK

8-21-32 192.....Scout

KANSAS

Map No. 40 Sec. 34 Twp. 24 R. 5W

Well No. 1-7 Miller

Meyerson Dey Company

Contractor

COMPILED

SECTION PLAT

330 Ft. from N. Line

Ft. from S. Line

330 Ft. from E. Line

Ft. from W. Line

	0		

Location

Rig up

Drilling and Remarks:

176 oil
40 water

2000 acid

RECORD

Cased in. ft.

Sand TC 3402

Gas

Oil

Total Depth 3501

PRODUCTION

1st 24 hrs. Nat.

1st 24 hrs. after shot

Gas Cu. Ft.

Dry Hole

Abandoned

Date

10-24-35 192

ORVAL MANNSCHRECK

Scout