

Reno


KANSAS

Form 51-5M 5-37 Petrol

Section 34 Township 24 Range 5-W

Well No. 1 - Showalter

Company Drillers Gas

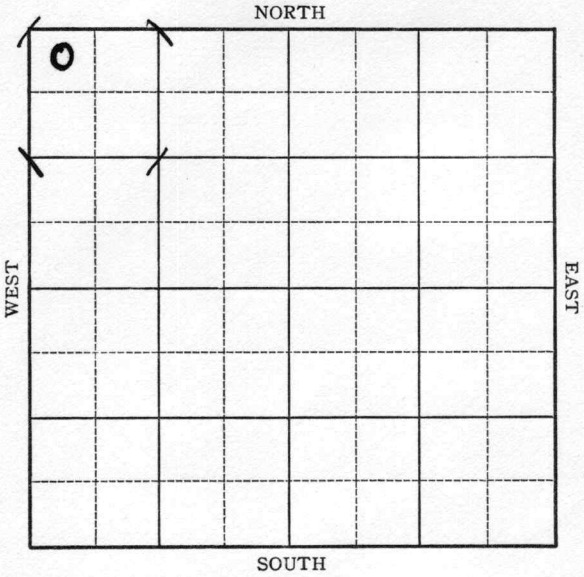

Sec. 34 Twp. 24 R. 5-W

Well No. #1 Showalter Farm

Drillers Gas Company


330 Ft. from N. Line

_____ Ft. from S. Line

_____ Ft. from E. Line

330 Ft. from W. Line

Elev. 1543

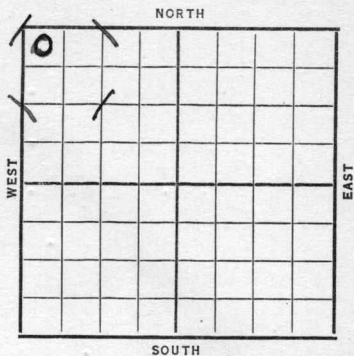

| Date | REPORT |
|-------|--------------------------------|
| 1937 | |
| 8/18 | Location |
| 8/28 | " |
| 9/3 | Mat. |
| 9/10 | B. R. R. |
| 9/17 | R. R. |
| 9/24 | " |
| 10/2 | " |
| 10/8 | " |
| 10/15 | 12" @ 128'. WOC. |
| 10/22 | Drlg. 1828'. |
| 10/29 | Drlg. 2982'. |
| 11/5 | Cha t 3394'. 7" @ 3399'. |
| | WOC. No shows. |
| 11/12 | " " " |
| 11/19 | 3½ M gas 3450'. |
| | Approx 50 bbls. oil per day |
| | at 3450-59'. |
| 11/26 | 2000 acid. Flow 57 bbls. oil 8 |
| | hrs. Shut in. |
| 12/3 | " " " |

OVER

1937

12/8

7" @ 3399'.

Chat 3394'.

T.D. 3459'.

2000 acid.

Potential 94 oil.

5 M gas.

COMPLETED

Reno **KANSAS**

Map No. _____ Sec. 34 Twp. 24 R. 5^w

Well No. 1 - Showalter

Drillers Gas Company

Contractor

FIRST REPORT

SECTION PLAT

| | | | |
|---|--|--|--|
| 0 | | | |
| | | | |
| | | | |
| | | | |

530 Ft. from N. Line

_____ Ft. from S. Line

_____ Ft. from E. Line

330 Ft. from W. Line

Location ✓

Rig up _____

Drilling and Remarks:

RECORD

Cased _____ in., _____ ft.

Sand _____

Gas _____

Oil _____

Total Depth _____

PRODUCTION

1st 24 hrs. Nat. _____

1st 24 hrs. after shot _____

Gas _____ Cu. Ft.

Dry Hole _____

Abandoned _____

Date

AUG 18 1937

H. D. Hatfield

Scout

Reno

KANSAS

Map No. 40 Sec. 34 Twp. 24 R. 5W

Well No. 1 Showalter

Drillers Gas

Company

Contractor

COMPLETED

NW/C

330 Ft. from N. Line

_____ Ft. from S. Line

_____ Ft. from E. Line

330 Ft. from W. Line

SECTION PLAT

| | | | |
|---|--|--|--|
| 0 | | | |
| | | | |
| | | | |
| | | | |

Location _____

Rig up _____

Drilling and Remarks:

2000 acid

94 oil

5 M gas

RECORD

Cased 7 in., 3399 ft.

Sand Chat 3394

Gas _____

Oil _____

Total Depth 3459

PRODUCTION

1st 24 hrs. Nat. _____

1st 24 hrs. after shot _____

Gas _____ Cu. Ft.

Dry Hole _____

Abandoned _____

Date

DEC 8 - 1937

19

H. D. Hatfield

Scout