

Stafford

DX 78-1

KANSAS

Section 34 Township 24 Range 13W

Well No. #1 Halley

Company Anschutz Drlg.

NORTH

WEST

EAST

0							

SOUTH

Stafford

KANSAS

SEC.	TWP.	R.
34	24	13 W

WELL NO.

1 Halley

FARM

COMPANY

Anschutz Drlg.

CONTRACTOR

Co. Tools

Wildcat


330 _____ Ft. from N. Line

_____ Ft. from S. Line

_____ Ft. from E. Line

330 _____ Ft. from W. Line

NW NW SW

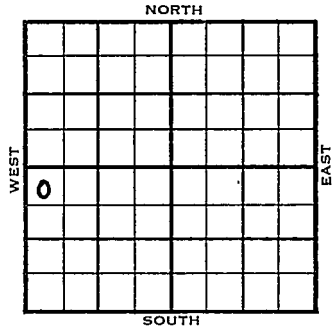


Shell - UHM

	ELEVATION	REPORT
1955	1933'	

3/2 Spud 2-25-55
8" @ 316
Drlg. 2700'

3/16 Spud 2-25-55, D&A; TD 4246
8" @ 316, Heeb 3444, Br Lime
3588, Lans 3614,
DST 3849-68, open 1 hr, Rec 62'
SOCM 450# B KC 3873, Ch. Cong
3976, Viola 4001, Simp. 4136,
Arb 4196,
TD 4246
D&A

ABANDONED

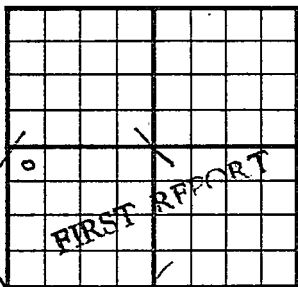County Stafford State KansasSec. 34 (Blk.
Twp.) 24 (Sur.
Rge.) 13W Map No.Operator Anschutz Drlg.Well No. 1 Farm HalleyElev. Location NW NW SW330 Ft. From N Line SW330 Ft. From W Line Quarter1st. Report MAR 2 1955

Completion


Remarks Shell - DHMCo. toolsSpudding Date 2-25-55Wildcat

Drlg. Data

8" @ 316 drlg. 2700

FABEN GILSTRAP

County Stafford State Kansas
 Sec. 34 (Blk.) 24 (Sur.) 13W Map No.
 Operator Anschutz Drlg.
 Well No. 1 Farm Halley
 Elev. 1933 Location NW NW SW

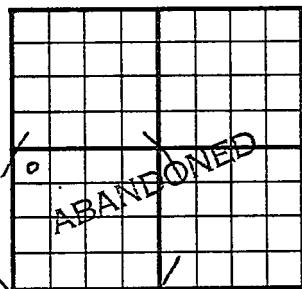

330 Ft. From N Line SW
330 Ft. From W Line Quarter

Ist. Report

Completion MAR 1 6 1955

Remarks Wildcat

Co. tools

Spudding Date 2-25-55

Drlg. Data D & A TD 4246

8" @ 316 Heeb. 3444 Br. lime 3588

Lans. 3614 DST 3849-68 open 1 hr.

Rec. 62' socm 450# B KC 3873

Ch. Cong. 3976 Viola 4001 Simp. 4136

Arb. 4196 TD 4246

D & A

FABEN GILSTRAF