


Section 34 Township 24 Range 15W

Well No. #2 Young


Company Skelly

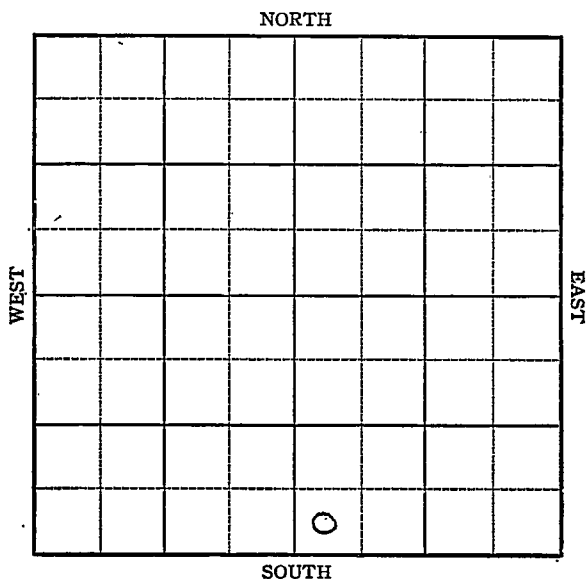

Sec. 34 Twp. 24 R. 15W

Well No. #2 Young Farm
Skelly Company

NORTH

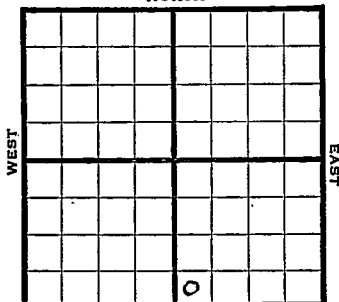

SOUTH

 Ft. from N. Line

330 Ft. from S. Line

 Ft. from E. Line

330 Ft. from W. Line

elev. 2028

1944

REPORT

5/3	Location
5/10	"
5/17	"
5/24	8" @ 975 WOC
5/31	Drlg. 2340
6/7	Drlg. 8400'
6/15	Lans 3757 Drlg. 4370
6/21	Viola 4239 Cherty Viola 4250 Simp Sd 4341 Simp Sd. 4354 Arb. 4427-30 TD 5" @ 4428 RUST
6/28	" " " " "
7/12	" " " " "

OVER

7/19 TD 4437
500 acid
Pump 175 oil plus 18 w in 17
hours
7/26 Arb 4427
5" @ 4428
500 acid
Pump 311 Pot.
TD 4437
Grav. 36.

COMPLETED

KANSASPool Name FarmingtonMap No. 83 Sec. 34 Twp. 24 R. 15WWell No. 2 YoungSkelly CompanyFIRST REPORT Contractor

SW SE

SECTION PLAT

Ft. from N. Line

330

Ft. from S. Line

Ft. from E. Line

330

Ft. from W. Line

Stafford CountyLocation X

Rig up

Drilling and Remarks:

RECORD

Cased _____ in., _____ ft.

Sand _____

Gas _____

Oil _____

Total Depth _____

PRODUCTION

1st 24 hrs. Nat. _____

1st 24 hrs. after shot _____

Gas _____ Cu. Ft.

Dry Hole _____

Abandoned _____

Date

MAY 3 1944 19S. J. LEWIS

Scout

KANSAS

Pool Name FarmingtonMap No. 83 Sec. 34 Twp. 24 R. 15WWell No. 2 YoungSkelly

Company

COMPLETED

Contractor

SW SE

SECTION PLAT

Ft. from N. Line

330

Ft. from S. Line

Ft. from E. Line

330

Ft. from W. Line

Stafford County

Location

Rig up

Drilling and Remarks:

Art 4427311 @ 4428500 @ 4429Pump 311 P & X36 1/2 ft

RECORD

Cased _____ in., _____ ft.

Sand _____

Gas _____

Oil _____

Total Depth 4427

PRODUCTION

1st 24 hrs. Nat. _____

1st 24 hrs. after shot _____

Gas _____ Cu. Ft.

Dry Hole _____

Abandoned _____

Date

JUL 26 1944

19

S. J. LEWIS

Scout