

KANSAS


FORM 51 5M 1-42 PETROL

Stafford

Section 34 Township 24 Range 15-W

Well No. #2 Campbell

Company S. Kelly

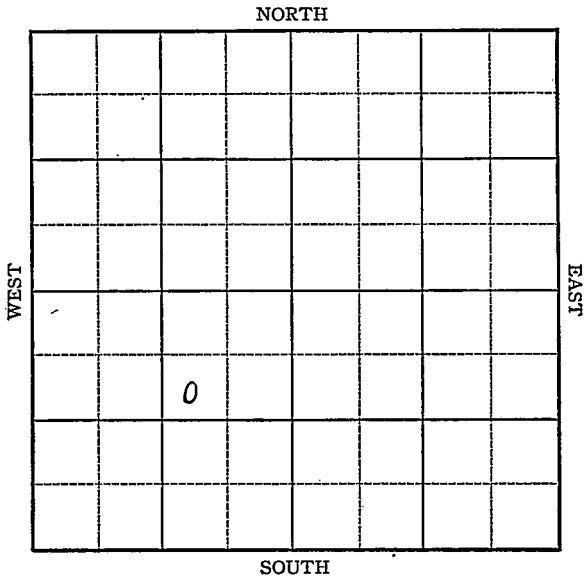


KANSAS

Stafford

Sec. 34 Twp. 24 R. 15-WWell No. #2 Campbell FarmSkelly Company990 Ft. from N. Line Ft. from S. Line990 Ft. from E. Line Ft. from W. Line

No Pool Name

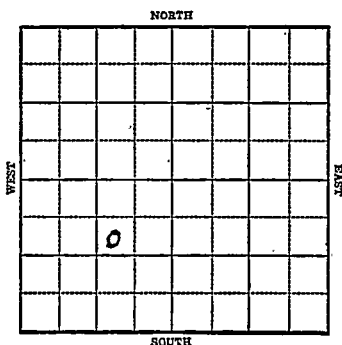

1943

Rev. 2028 R E P O R T

7/28

Rotary

8/4

8" @ 970'

Drlg. 1000'

8/11

Drlg. 3050'

8/18

Lans 3757

Miss 4151

Viola 4256

Arb 4401

T.D. 4410

5" @ 440 Rust

8/25

" " "

9/1

T.D. 4424-330 oil in 15 hrs

2000 acid

Pump 360 in 44 hrs.

9/8

1500 acid

9/15

Arb 4406

5" @ 4407

3500 acid

Echo Pot. 2790

T.D. 4424

Gravity 36.4

COMPLETED

KANSAS**Stafford**Map No. 83 Sec. 34 Twp. 24 R. 15WWell No. 2 CampbellSkelly

Company

FIRST REPORT

Contractor

SW NE SW

SECTION PLAT990 Ft. from N. Line

Ft. from S. Line

990 Ft. from E. Line

Ft. from W. Line

No Pool Name

Location

Rig up

Drilling and Remarks:

Rotary**RECORD**

Cased _____ in., _____ ft.

Sand _____

Gas _____

Oil _____

Total Depth _____

PRODUCTION

1st 24 hrs. Nat. _____

1st 24 hrs. after shot _____

Gas _____ Cu. Ft.

Dry Hole _____

Abandoned _____

Date

JUL 28 1943 19S. J. LEWIS Scout

KANSAS
 Map No. 83 Sec. 34 Twp. 24 R. 15W

Well No. 2 Campbell

Skelly Company

COMPLETED Contractor

SW NE SW

SECTION PLAT

990 Ft. from N. Line

 Ft. from S. Line

990 Ft. from E. Line

 Ft. from W. Line

	0		1

Farmington Pool

Location

Rig up

Drilling and Remarks:

Per 44406
5" 44407
2500 casing
Echo PT 2790
36 1/2 ft

RECORD

Cased in., ft.

Sand

Gas

Oil

Total Depth 4424

PRODUCTION

1st 24 hrs. Nat.

1st 24 hrs. after shot

Gas Cu. Ft.

Dry Hole

Abandoned

Date

SEP 15 1943

19

S. J. LEWIS

Scout