


Stafford

Section 34 Township 24 Range 15W

Well No. #4 Campbell

Company Skelly

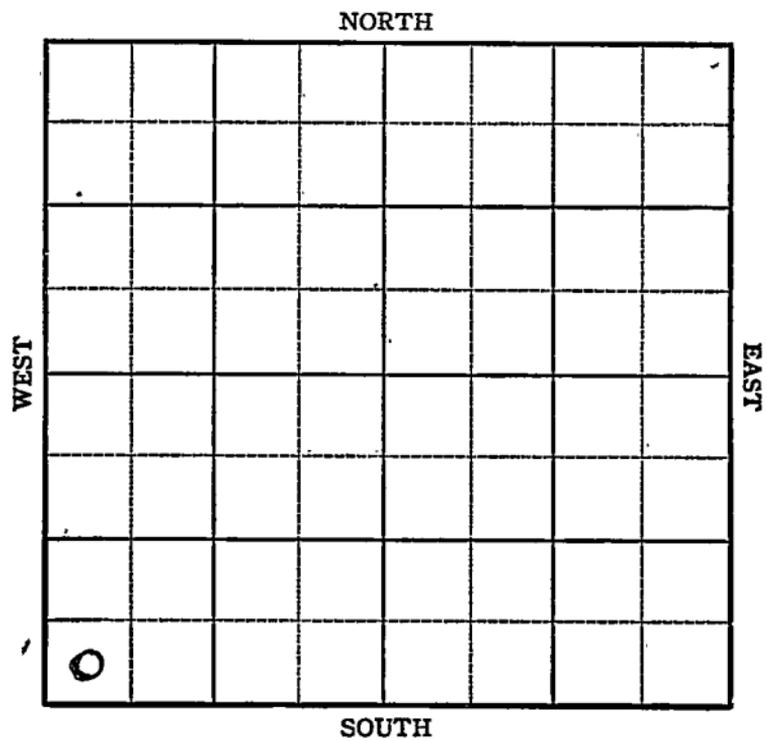

KANSAS

Stafford

Sec. 34 Twp. 24 R. 15-W


Well No. #4 Campbell Farm
Skelly Company

_____ Ft. from N. Line

330 Ft. from S. Line

_____ Ft. from E. Line

330 Ft. from W. Line

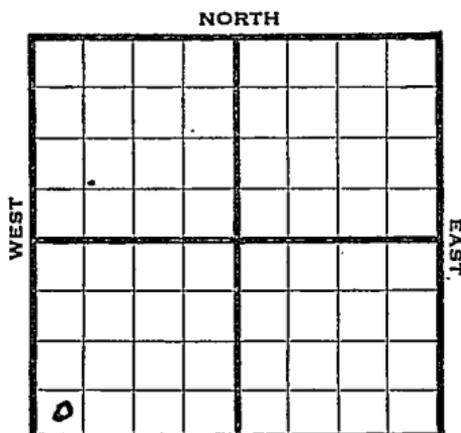

Framington

Elev. 2034

SOUTH

1944

REPORT

3/15

Location.

3/22

"

3/29

"

4/5

Drlg. 965

4/12

Drlg. 2550

4/19

8" @ 987
Drlg. 3600

4/26

Lans 3766
SO 3912-20, 3933-48
Cong 4161
Miss 4227 ?
Kind 4243
Viola 4257
Simp Sd 4363 SO
Arb 4426-37 TD
SO
5" @ 4426
Rust

5/3

5" @ 4428 corrected

5/10

TD 4437 1000' oil 6 hrs.
Total 2100' oil

OVER

1944

5/17

Arbuckle 4426

5" - 4428

Pot. - Pump 108

Gravity 40.9

Total Depth 4437

COMPLETED

KANSAS

Map No. 23 Sec. 34 Twp. 24 R. 15W

Well No. 4 Campbell

Skelly Company

FIRST REPORT Contractor

SW/C

SECTION PLAT

_____ Ft. from N. Line

330 Ft. from S. Line

_____ Ft. from E. Line

330 Ft. from W. Line

Farmington Pool

Location X

Rig up _____

Drilling and Remarks:

RECORD

Cased _____ in., _____ ft.

Sand _____

Gas _____

Oil _____

Total Depth _____

PRODUCTION

1st 24 hrs. Nat. _____

1st 24 hrs. after shot _____

Gas _____ Cu. Ft.

Dry Hole _____

Abandoned _____

Date

MAR 15 1944 19

S. J. LEWIS Scout

Pool Name Farmington

KANSAS

Map No. 77 Sec. 34 Twp. 24 R. 15 WWell No. 4 CampbellSkelly

Company

COMPLETED

Contractor

SW/C

SECTION PLAT

_____ Ft. from N. Line

330

_____ Ft. from S. Line

_____ Ft. from E. Line

330

_____ Ft. from W. Line

Stafford County

RECORD

Location _____

Cased _____ in., _____ ft.

Rig up _____

Sand _____

Drilling and Remarks:

Gas _____

Oil _____

Total Depth 4487

PRODUCTION

1st 24 hrs. Nat. _____

1st 24 hrs. after shot _____

Gas _____ Cu. Ft.

Dry Hole _____

Abandoned _____

Oil 44265" @ 4425.Pump 108 BT40 E/G

Date

MAY 17 1944

19

S. J. LEWIS Scout