

KANSAS


Stafford

FORM 51 5M, BRIX

Section 34 Township 24 Range 15W

Well No. #2 North Campbell

Company Skelly

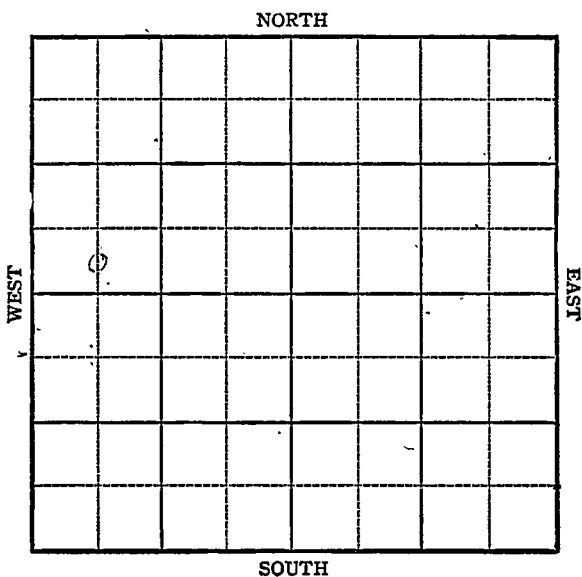

KANSAS

Stafford

Sec. 34 Twp. 24 R. 15W

Well No. #2, North Campbell Farm
Skelly Company


Farmington
CSL SW NW

 Ft. from N. Line

330 Ft. from S. Line

 Ft. from E. Line

660 Ft. from W. Line

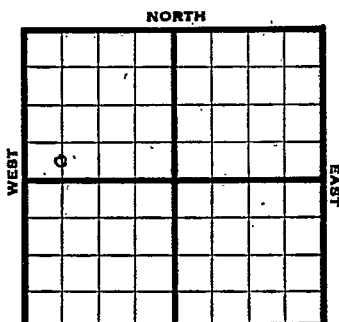

elev. 3022 2032

1944

REPORT

6/14 Location

6/21 Rotary

6/28 Drlg 400

7/12 Drlg 2755

7/19 Lans 3775

Viola 4191

Arb 4371-74 TD

Swb 5" @ 4372 RUST

7/26 " " " " " " " "

8 /9 Arb. 4371

5" @ 4372

2500 Acid

Pump 756 Pot.

Grav. 36.4

TD 4390

COMPLETED

KANSASPool Name FarmingtonMap No. 83 Sec. 34 Twp. 24 R. 15WWell No. 2 North CampbellSkelly

Company

FIRST REPORT

Contractor

C S L SW NW**SECTION PLAT**

b			

Ft. from N. Line

330

Ft. from S. Line

Ft. from E. Line

660

Ft. from W. Line

Stafford CountyLocation **X**

Rig up

Drilling and Remarks:

RECORD

Cased _____ in., _____ ft.

Sand _____

Gas _____

Oil _____

Total Depth _____

PRODUCTION

1st 24 hrs. Nat. _____

1st 24 hrs. after shot _____

Gas _____ Cu. Ft.

Dry Hole _____

Abandoned _____

Date

JUN 14 1944 19S. J. LEWIS

Scout

Pool Name Farmington

KANSAS
 Map No. 82 Sec. 34 Twp. 24 R. 15W

Well No. 2 North Campbell


Skelly Company

COMPLETED

Contractor

C S L SW NW

SECTION PLAT

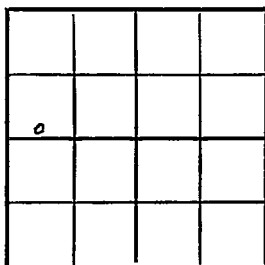 Ft. from N. Line330 Ft. from S. Line Ft. from E. Line660 Ft. from W. LineStafford CountyLocation Rig up

Drilling and Remarks:

Core 43715' 10" 43722500 acilPump 756 ft36 1/2 Gr

RECORD

Cased in., ft.Sand Gas Oil Total Depth 4370

PRODUCTION

1st 24 hrs. Nat. 1st 24 hrs. after shot Gas Cu. Ft.Dry Hole Abandoned

Date

AUG 9 1944 19 S. J. LEWIS Scout