



Sec. 34 Twp. 24 R. 15W

Well No. #2 Harris Farm

Skelly Company


Farmington

         Ft. from N. Line

330 Ft. from S. Line

990 Ft. from E. Line

         Ft. from W. Line

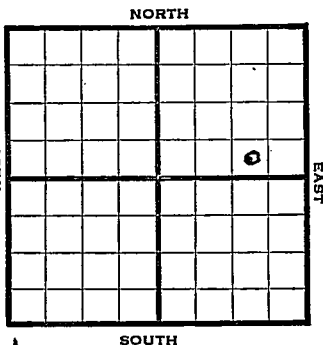

*El. 2021*

1944

REPORT

7/19

Location

7/26

"

8/2

"

8/9

"

8/16

"

8/23

Rotary

8/30

"

9/8

"

9/13

"

9/21

"

9/28

"

10/4

8" @ 967

Drlg. 1940

10/11

Drlg. 4612

10/18

Drlg. 4153

10/25

Lans 3756

Vioal 4249

Simp sd. 4342

Arb 4405

TD 4408

14" @ 4407 RUS<sup>1</sup>

11/1

" " " "

11/8

TD 4466 3000<sup>1</sup> wtr. SD

11/16

" " " " " "

11/24

" " " " " " " "

OVER

1944

11/29 Arb. 4405  
5" @ 4407  
TD 4466'  
3000' water

ABANDONED

**KANSAS**

Pool Name Farmington

Map No. 8 3 Sec. 34 Twp. 24 R. 15 W

Well No. 2 Harris

Skelly

Company

**FIRST REPORT**

Contractor

SW SE NE

**SECTION PLAT**


\_\_\_\_\_ Ft. from N. Line

330

\_\_\_\_\_ Ft. from S. Line

990

\_\_\_\_\_ Ft. from E. Line

\_\_\_\_\_ Ft. from W. Line

Stafford County

Location X

Rig up \_\_\_\_\_

Drilling and Remarks:

**RECORD**

Cased \_\_\_\_\_ in., \_\_\_\_\_ ft.

Sand \_\_\_\_\_

Gas \_\_\_\_\_

Oil \_\_\_\_\_

Total Depth \_\_\_\_\_

**PRODUCTION**

1st 24 hrs. Nat. \_\_\_\_\_

1st 24 hrs. after shot \_\_\_\_\_

Gas \_\_\_\_\_ Cu. Ft.

Dry Hole \_\_\_\_\_

Abandoned \_\_\_\_\_

Date

JUL 1 9 1944

19

S. J. LEWIS

Scout

Pool Name Farmington

Map No. 83 Sec. 34 Twp. 24 R. 15W

Well No. 2 Harris

Skelly Company

ABANDONED Contractor

SW SE NE

SECTION PLAT

         Ft. from N. Line

330 Ft. from S. Line

990 Ft. from E. Line

         Ft. from W. Line


Stafford

Location                                 

Rig up                                 

Drilling and Remarks:

*Core 4405*

*5' @ 4407*

*3000' water*

**RECORD**

Cased          in.,          ft.

Sand                                 

Gas                                 

Oil                                 

Total Depth 4466

**PRODUCTION**

1st 24 hrs. Nat.                                 

1st 24 hrs. after shot                                 

Gas                                  Cu. Ft.

Dry Hole                                 

Abandoned                                 

Date

NOV 29 1944 19

L. S. LEWIS Scout