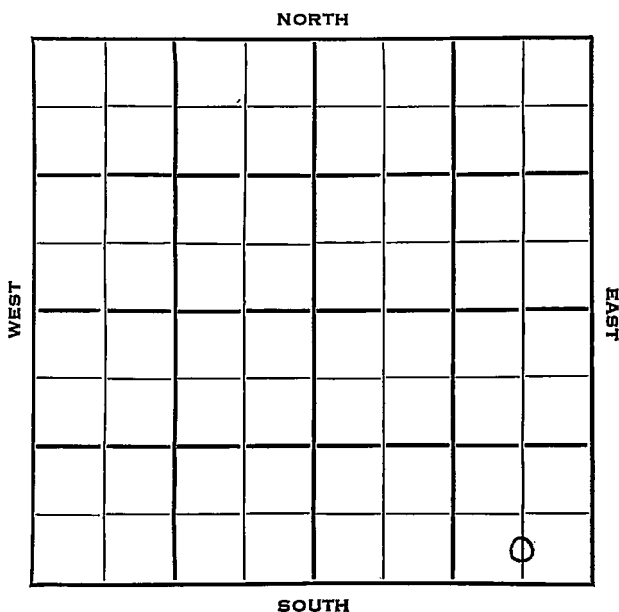


Section 34 Township 24 Range KANSASWell No. #1 YoungCompany Dozier Oil

Stafford

KANSAS

SEC.	TWP.	R.
34	24	15W

WELL NO.

#1 Young

FARM

COMPANY

Dozier Oil

CONTRACTOR

Stag Drlg.

Farmington Pool


NORTH

Ft. from N. Line

330 Ft. from S. Line

660 Ft. from E. Line

Ft. from W. Line

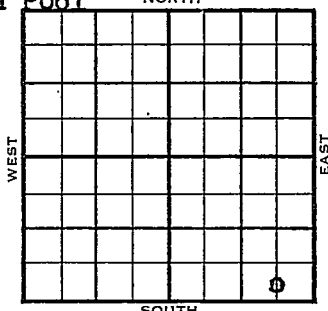


C S L SE SE

	ELEVATION	REPORT
1953	2019	
9/30	Spud 9-28-53 8" @ 300' Drlg 1600'	
10/7	Drlg 3415'	
10/14	Br. L. 3723, Lans 3741, B KC 4025, Cong 4134, Miss 4161, V. 4231 Drlg 4293'	
10/21	Spud 9-28-53 D & A TD 4433' 8" @ 300' Br. Lime 3723, Lans 3741, B KC 4025, Cong 4134, Miss 4161, Viola 4231, Simp 4333, Arbt 4423, TD 4433' D & A	

ABANDONED

8" @ 300 drlg. 1600

J. G. McGEHEE

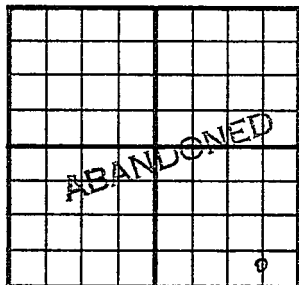County Stafford State KansasSec. 34 (Blk. 24) (Sur. 15W) Map No. 15WOperator Dozier OilWell No. 1 Farm YoungElev. 2019 Location C S L SE SE330 Ft. From S Line SE660 Ft. From E Line Quarter1st. Report Completion OCT 21 1953Remarks Farmington PoolStag Drlg. - Contr.Spudding Date 9-28-53Drlg. Data D & A TD 44338" @ 300 Br. lime 3723 Lens. 3741B KC 4025 Cong. 4134. Miss. 4161Viola 4231 Simp. 4333 Arb. 4423TD 4433D & A

J. G. McGEHEE