


Section 34 Township 24 Range 15<sup>W</sup>

Well No. #1 Young

Company Davis-Child

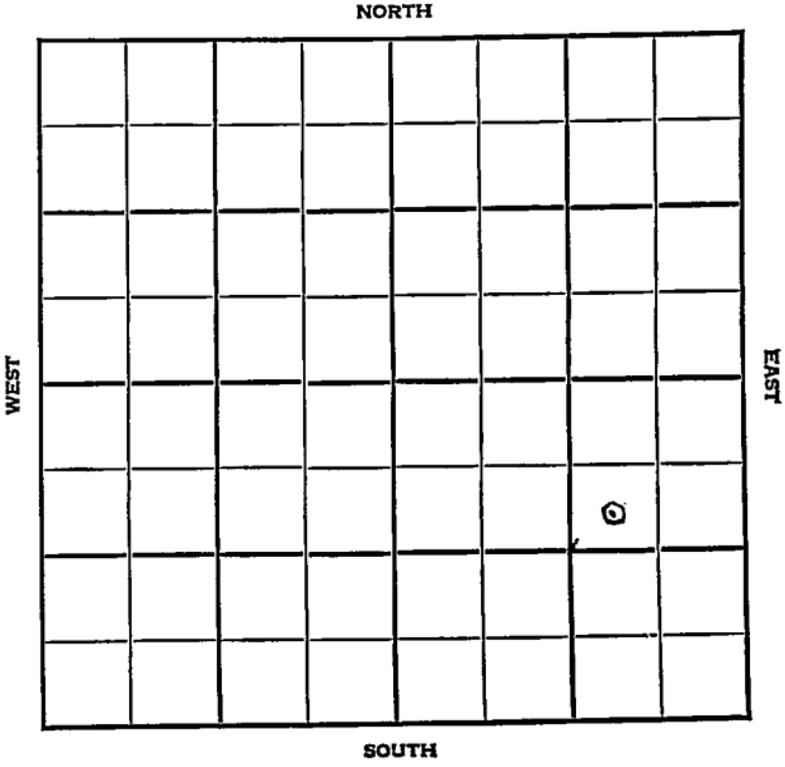

Sec. 34 Twp. 24 R. 15W

Well No. #1 Young Farm#


Davis-Child Company  
Farmington

990 Ft. from N. Line

\_\_\_\_\_ Ft. from S. Line

990 Ft. from E. Line

\_\_\_\_\_ Ft. from W. Line

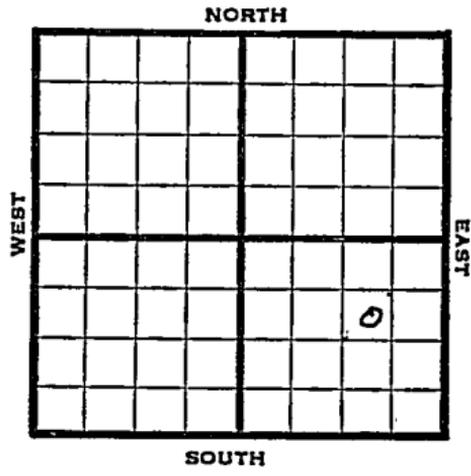

SW NE SE

1948	Elev. 2022'	REPORT
1/28	RUR	
2/4	"	
2/11	"	
2/18	"	
2/25	"	
3/3	"	
3/10	"	
3/17	"	
3/24	"	
3/31	8" @ 285'	
	Drlg. 1900'	
4/7	Lansing 2734'	
	Drlg. 3760'	
4/14	Lansing 3754'	
	Mississippi 4168'	
	Viola 4211'	
	Simpson 4327'	
	Arbuckle 4415'	
	TD 4418'	
	5" @ 4415'	
	RUST	
4/21	Arbuckle 4415'	
	TD 4428'	
	<b>ABANDONED</b>	

Map No. \_\_\_\_\_ Sec. 34 Twp. 24 R. 15W

Well No. 1 Young

Davis-Child Company

**FIRST REPORT**

Contractor

SW NE SE


**SECTION PLAT**

990 Ft. from N. Line

\_\_\_\_\_ Ft. from S. Line

990 Ft. from E. Line

\_\_\_\_\_ Ft. from W. Line

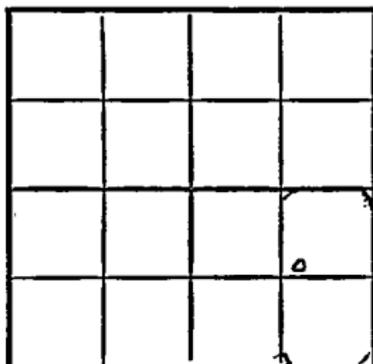

Stafford County

Location \_\_\_\_\_

Rig up \_\_\_\_\_

Drilling and Remarks:

R U R

**RECORD**

Cased \_\_\_\_\_ in., \_\_\_\_\_ ft.

Sand \_\_\_\_\_

Gas \_\_\_\_\_

Oil \_\_\_\_\_

Total Depth \_\_\_\_\_

**PRODUCTION**

1st 24 hrs. Nat. \_\_\_\_\_

1st 24 hrs. after shot \_\_\_\_\_

Gas \_\_\_\_\_ Cu. Ft.

Dry Hole \_\_\_\_\_

Abandoned \_\_\_\_\_

Date

JAN 28 1948 19

S. J. LEWIS Scout

