

Finney


DX 78-1

KANSAS

Section 34 Township 24 Range 32W

Well No. #1 Emma Wood "B"

Company Stanolind

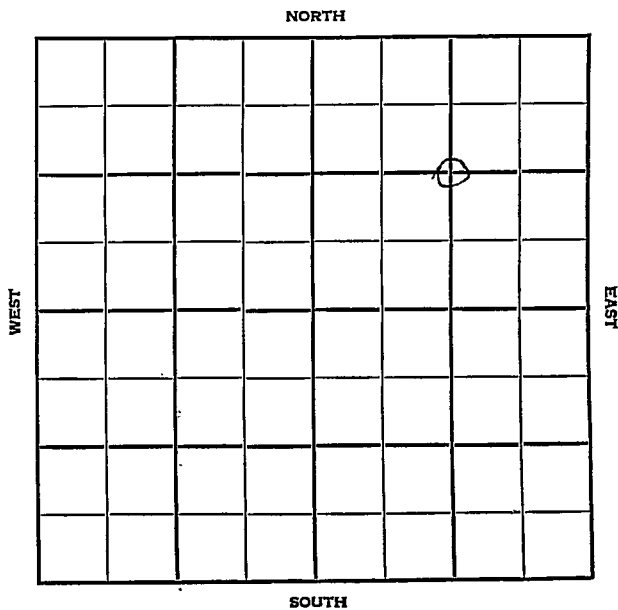

Finney

KANSAS

SEC.	TWP.	R.
34	24	32 W

WELL NO.

#-1 Emma Wood "B"

FARM

COMPANY

Stanolind

CONTRACTOR

Noble Drlg.

Hugoton Pool


1320 Ft. from N. Line

Ft. from S. Line

1320 Ft. from E. Line

Ft. from W. Line

C NE/4

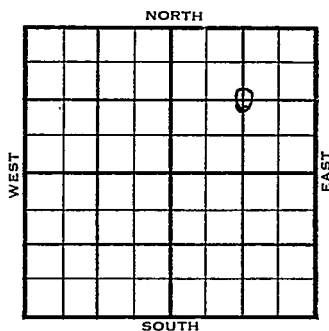

1954

ELEVATION

2849'

REPORT

12/1

Location

1955

1/5

Spud 11-29-54 - Gas Well

TD 2640'

8-5/8" @ 906'

Her. 2551', Kri. 2577', Win. 2610'

TD 2640'

5" @ 2610'

CO to 2604'

18/2555-58', 12/2560-62', 42/2564-71',

12/2576-78, 48/2584-92, 3750A

Sd-frac 1500A

2,278,000 cfg 50 gwaph

Comp. 4,668,000 cfgpd, 400#

COMPLETED

