


Section 34 Township 24 Range 34 W

Well No. # 28 Brown

Company Northern Natural Gas

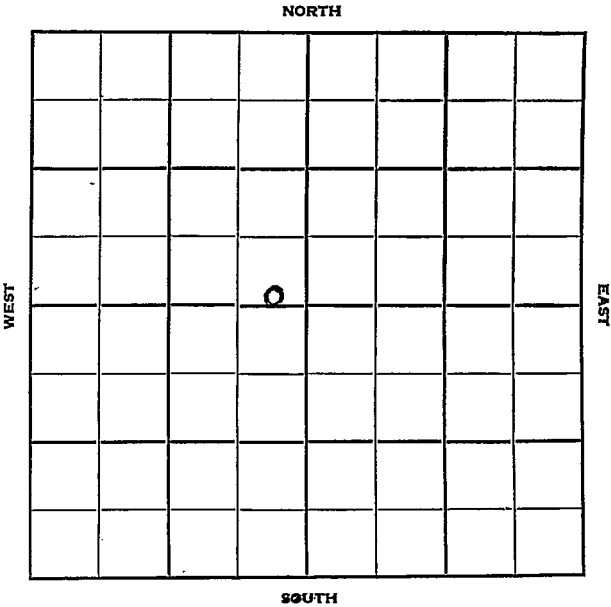

Sec. 34 Twp. 24 R. 34W

Well No. #28 Brown Farm

Northern Natural Gas

Company

Contractor

Ft. from N. Line

150


Ft. from S. Line

300

Ft. from E. Line

Ft. from W. Line

SE NW

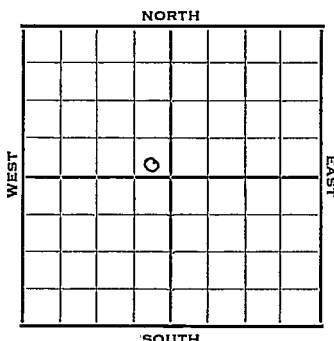

1952

Elv. 2980'

REPORT

6/11

Location

6/18

10" @ 449

Drlg. 790'

6/25

RTD 2467' 7" @ 2438'

7/2

NR

7/9

Spud 6-13-52 Gas Well TD 2712

10" @ 449 7" @ 2438


Her. 2440 Kri 2493 Win 2553

Ft. Riley 2612 TD 2712

23,000 A Comp. 21,507,000 gas

397#

COMPLETED

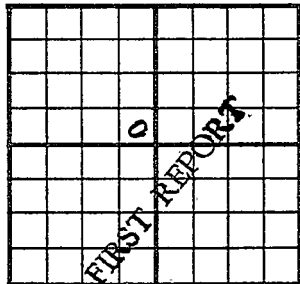County Finney State KansasSec. 34 (Blk.) 24 (Sur.) 34W Map No.Operator Northern Natural GasWell No. 28 Farm BrownElev. _____ Location SE NW150 Ft. From S Line NW300 Ft. From E Line Quarter1st. Report JUN 11 1952

Completion _____

Remarks _____

Spudding Date _____

Drlg. Data _____

Location


J. G. McGEHEE

County Finney State Kansas
 Sec. 34 (Blk.) 24 (Sur.) 34W Map No.

Operator Northern Natural Gas

Well No. 28 Farm Brown

Elev. 2980 Location SE NW

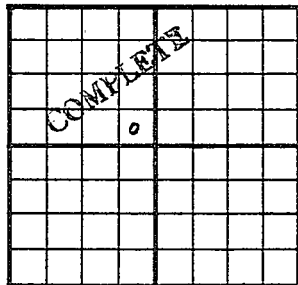

150 Ft. From S Line NW

300 Ft. From E Line Quarter

1st. Report

Completion 1111 9 1952

Remarks

Spudding Date 6-13-52

Drilg. Data Gas well TD 2712

10" @ 449 7" @ 2438 Her. 2440

Kri. 2493 Win. 2553 Ft. Riley 2612

TD 2712 23000 A Comp. 21,507,000 gas
397#

J. G. McGEHEE