


Section 35 Township 24 Range 14W

Well No. 1 Bowker

Company Deep Rock

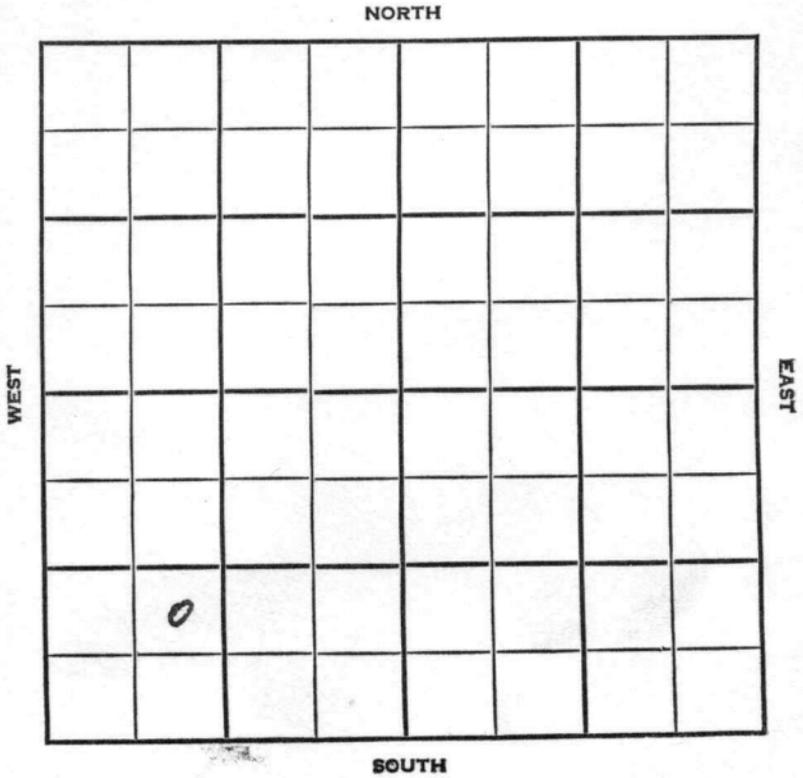

Stafford

KANSAS

SEC. 35	TWP. 24	R. 11W
-------------------	-------------------	------------------

WELL NO. **#1 Bowker**

COMPANY **FARM**

Deep rock

CONTRACTOR **Gabbert-Jones**


Wildcat.

_____ Ft. from N. Line

990 _____ Ft. from S. Line

_____ Ft. from E. Line

990 _____ Ft. from W. Line

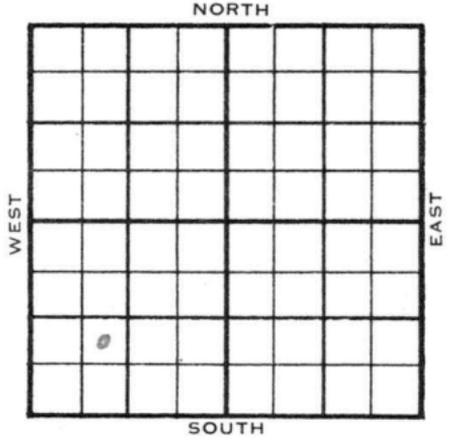

NE SW SW

Phillips - DHM

	ELEVATION	REPORT
1954	1954'	
9/1		Spud 8-28-54 8" @ 290'
10/20		Drlg. 1230' Spud 8-28-54 Oil Well TD 4283' 8" @ 290' KC 3649', DST 3768'-90' opn 1 hr, rec 92' vsocm 1370# DST 3795'-3826' opn 1 hr, rec 30' 0 & gcm 180' Muddy gassy oil, 1300# Heeb 3483', Br. Lime 3617', Miss 3990', Kh. 4009', Viola 4071', Simp 4213' Arb. 4255' TD 4285' Schlumberger Tops: Heeb 3481', Lans 3648', B KC 3917', Miss 3990', Kh. 4010', Viola 4070', Simp 4212', Arb. 4255' TD 4283' 5" @ 3910' CO to 3836 20/ 3821-26 5' Muddy s.w. SSO 250 M -A CO to 3817 28/ 3809-16 1 gwph 250 A 3/4 bwph SP 3789 A-frac CO to 3806 36/ 3794-3803

1954

Information brought forward.

10/20 $\frac{3}{4}$ bo 250 A F/ 86 bo 13 hr.
F/ 6 boph
Comp F/ **135** bopd.

COMPLETED

County **Stafford** State **Kansas**

Sec. **35** (Blk. Twp.) **24** (Sur. Rge.) **14W** Map No.

Operator **Deep Rock**

Well No. **1** Farm **Bowker**

Elev. Location **NE SW SW**

990 Ft. From **S** Line **SW**

990 Ft. From **W** Line Quarter

1st. Report **SEP 1 1954**

Completion

Remarks **Phillips - DEIM**

Gabbert-Jones - Contr.

Spudding Date **8-28-54**

Drlg. Data **Wildcat**

8" @ 290 drlg. 1230

FABEN GILSTRAP


County Stafford State Kansas

Sec. 35 (^{Bik.}Twp.) 24 (^{Sur.}Rge.) 14W Map No.

Operator Deep Rock

Well No. 1 Farm Bowker

Elev. 1954 Location NE SW SW

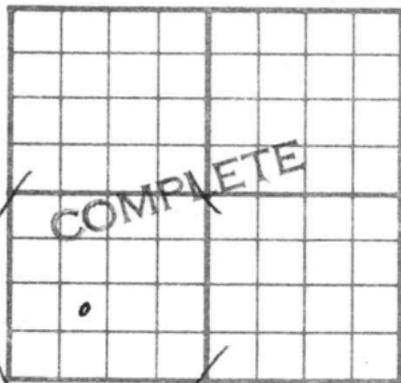

990 Ft. From S Line SW

990 Ft. From W Line Quarter

1st. Report

Completion OCT 20 1954

Remarks Wildcat

Gabbert-Jones - Contr.

Spudding Date 8-28-54

Drlg. Data Oil well TD 4283

8" @ 290 KC 3649 DST 3768-90

open 1 hr. Rec. 92' vsocm 1370#

DST 3795-3826 open 1 hr. Rec. 30' o &

gcm 180' muddy gassy oil 1300#

Heeb. 3483 Br. lime 3617 Miss. 3990

Kh. 4009 Viola 4071 Simp. 4213

Arb. 4255 TD 4285 SCHLUMBERGER TOPS

Heeb. 3481 Lans. 3648 B KC 3917

Miss 3990 Kh. 4010 Viola 4070

Simp. 4212 Arb. 4255 TD 4283 5" @ 3910

CO to 3836 20/ 3821-26 5' muddy sw SSO

250 M-A CO to 3817 28/ 3809-16

1 gwph 250 A 3/4 bwph SP 3789

A-frac CO to 3806 36/ 3794-3803

FABEN GILSTRAP

Misc.
 Picture Map
 Scout Cards
 Land Small Map

Orig. Data

$\frac{1}{4}$ bo 250 A F/86 bo 13 hr.

F/6 bo 9 F/135 bo 9

J

OCT 27 1954