DX 78-1

Stafford.

KANSAS

Section 35 Township 24 Range 14W

Well No. #2 Bowker

Company Deep Rock & Phillips Pet.

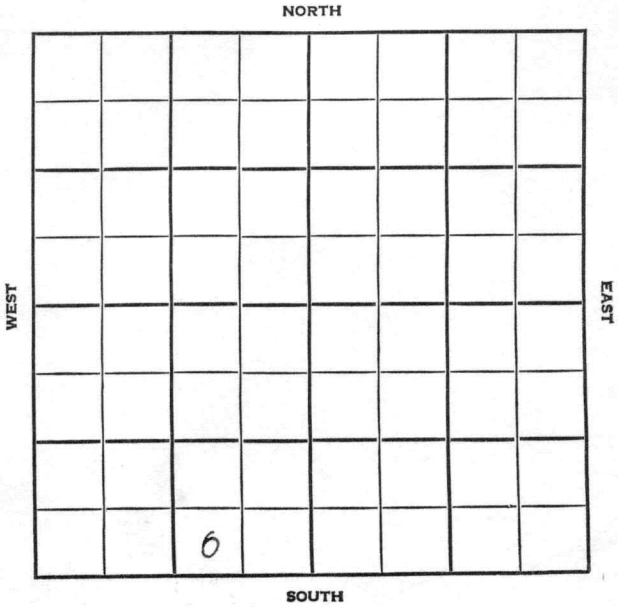

Stafford

KANSAS

SEC.	TWP.	R.
35	24	14W

WELL NO.

#2 Bowker FARM

COMPANY

Deep Rock & Phillips Pet.

CONTRACTOR

Gabbert-Jones

N. Cephas Pool

_____ Ft. from N. Line

330 Ft. from S. Line

990 Ft. from E. Line

_____ Ft. from W. Line

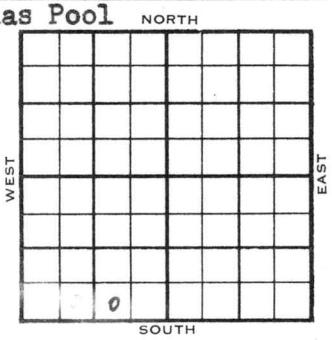

SW SE SW

1954	ELEVATION 1951' REPORT
12/1	Spud 11-24-54 10" @ 305' Drlg. 2963'
1955 1/26	Spud 11-24-54 Oil Well TD 4033' 10" @ 305' Anhy 855' Heeb 3484' Br. Lime 3622' Lans 3653' DST 3706'-18' opn 1 hr, gas in 32 min rec 270' oil 1320# DST 3762'-79' opn 1 hr, gas in 2 min 1,200,000 cfg 2,020,000 cfg rec 60' gcm 1650# DST 3797'-3809' opn 1 hr, rec 90' gcsw, 180' s.w. 740# B KC 3918' Miss 3986' Kh. 4010' TD 4033' 5" @ 3987' CO 32/ 3794-3802 750 M-A perf / 3794-3802 CO 32/ 3709-17 S/ 1 boph 500 A F/ 300 bf. 50% oil 12 hr. dec. to 150 bf. 10% oil CO to 3749 24/ 3708-14 250 A S/ 3½ bfph Mor-flo S/ 5½ boph Comp 93 bopd. 20% Wtr. COMPLETED

DX-78

FORM 275 FOR SALE BY KANSAS BLUE PRINT CO.

County Stafford State Kansas

Sec. 35 (Blk. Twp.) 24 (Sur. Rge.) 14W Map No.

Operator Deep Rock & Phillips Pet.

Well No. 2 Farm Bowker

Elev. Location SW SE SW

330 Ft. From S Line SW

990 Ft. From E Line Quarter

1st. Report DEC 1 1954

FIRST REPORT

Completion

Remarks

Gabbert-Jones - Contr.

Spudding Date 11-24-54

N. Cephas Pool

Drlg. Data

10" @ 305 drlg. 2963

FABEN GILSTRAP

FORM 275 FOR SALE BY KANSAS BLUE PRINT CO.

County Stafford State Kansas

Sec. 35 (Blk. Twp.) 24 (Sur. Rge.) 14W Map No.

Operator Deep Rock & Phillips Pet.

Well No. 2 Farm Bowker

Elev. 1951 Location SW SE SW

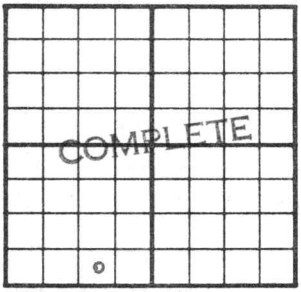

330 Ft. From S Line SW

990 Ft. From E Line Quarter

1st. Report

Completion JAN 26 1955

Remarks N. Cephas Pool

Gabbert-Jones - Contr.

Spudding Date 11-24-54

Drlg. Data Oil well TD 4033

10" @ 305 Anhy 855 Heeb. 3484

Br. lime 3622 Lans. 3653 DST 3706-18

open 1 hr. gas in 32 min. Rec. 270' oil

1320# DST 3762-79 open 1 hr. gas in

2 min. 1,200,000 cfg 2,020,000 cfg

Rec. 60' gcm 1650# DST 3797-3809

open 1 hr. Rec. 90' gcsw 180' sw

740# B KC 3918 Miss. 3986 Kh. 4010

TD 4033 5" @ 3987 CO 32/ 3794-3802

750 M-A perf/ 3794-3802 CO 32/ 3709-

17 S/ 1 boph 500 A F/ 300 bf 50% oil

12 hr. dec. to 150 bf 10% oil

CO to 3749 24/ 3708-14 250 A

S/ 3½ bfph Mor-flo S/ 5½ boph

Comp. 93 bopd 20% wtr.

FABEN GILSTRAP