


Section 35 Township 24 Range 14W

Well No. #3 Bowker

Company Deep Rock & Phillips Pet.

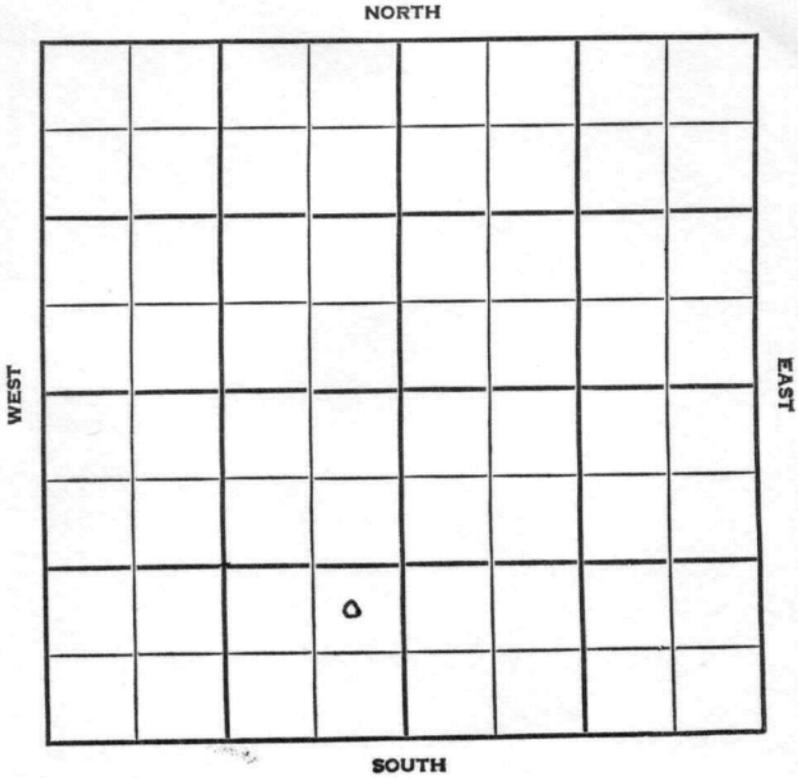

Stafford KANSAS

SEC.	TWP.	R.
35	24	14W

WELL NO. 3 Bowker FARM

COMPANY Deep Rock & Phillips Petr.

CONTRACTOR Gabbert-Jones


N. Cephas Pool

_____ Ft. from N. Line

990 _____ Ft. from S. Line

330 _____ Ft. from E. Line

_____ Ft. from W. Line

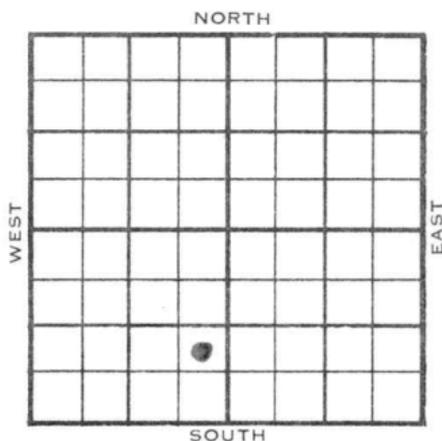

NE SE SW

1955	ELEVATION	REPORT
	1952'	
4/13		Spud 4-8-55
4/27		10" @ 213', WOC
		Spud 4-8-55 - D&A
		TD 3949'
		10" @ 213'
		Lans. 3649'
		DST 3670-95', opn 1 hr., rec. 60'
		α&gcm, 810#
		DST 3710-27', opn 1hr., rec. 90' mud,
		1130#
		DST 3774-90', opn 1 hr., rec. 60' mud,
		920#
		TD 3949'
		Schl Tops: Heeb. 3486', Br Lime 3626'
		Lans. 3655', B KC 3934'
		D&A
		ABANDONED

