

KANSAS

Stafford County

FORM 51 5M PETROL

Section 35 Township 24 Range 15W

Well No. 1 Barstow

Company Cities Service

NORTH

0							

SOUTH

WEST EAST

KANSAS

Stafford

Sec. 35 Twp. 24 R. 15WWell No. 1 Barstow Farm

Cities Service Company

Farmington

Ft. from N. Line

330


Ft. from S. Line

Ft. from E. Line

330 Ft. from W. Line

SW/c

Elev. 2020

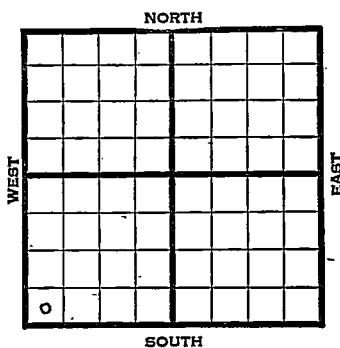

1945

REPORT

5/16

10" -260
1100

5/24

Drlg. 2718

5/31

Drlg. 3640

6/8

Drlg. 4225

6/14

Lams 3736
Viola 4491 — ?
Simp Sd 4341
Arb 4400
5" @ 4401
TD 4415
900 Oil 9½ hrs.

6/21

Pump 121 fluid 15 hrs 4% W
PB 4411

6/28

Pump 85 fluid in 8 hrs 4% W PB 4409

7/3

1000 acid.

Pump 240 fluid in 13 hrs. 22% wtr.

7/11

" " " " " " " "

7/19

" " " " " " " "

7/26

" " " " " " " "

8/8

Arb. 4400
5" @ 4401'
T.D. 4415'
P.B. 4409'
1000 acid
Depth Pot 930 oil
plus 438 water
Gravity 39

COMPLETED

Kansas Pool Name FarmingtonMap No. 83 Sec. 35 Twp. 24 R. 15WWell No. 1 BarstowCities Service


Company

FIRST REPORT

Contractor

SW/c

SECTION PLAT

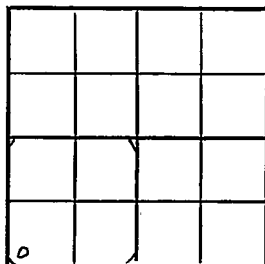 Ft. from N. Line330 Ft. from S. Line Ft. from E. Line330 Ft. from W. LineStaffordLocation Rig up

Drilling and Remarks:

10"-260
1100

RECORD

Cased in., ft.Sand Gas Oil Total Depth

PRODUCTION

1st 24 hrs. Nat. 1st 24 hrs. after shot Gas Cu. Ft.Dry Hole Abandoned

Date

MAY 1 6 1945

19

S. J. LEWIS

Scout

KANSAS

Pool Name FarmingtonMap No. 83 Sec. 35 Twp. 24 R. 15WWell No. 1 Barstow

Cities Service

Company

COMPLETED

Contractor

SW/c

E 12020
SECTION PLAT

Ft. from N. Line

330 Ft. from S. Line

Ft. from E. Line

330 Ft. from W. Line

Stafford County

Location

Rig up

Drilling and Remarks:

Ar 4400

5' 10" 4401

PB 4409

1000 acril

Dep to 12' 930 acril

438 Water

35° S

Date

RECORD

Cased _____ in. _____ ft.

Sand _____

Gas _____

Oil _____

Total Depth 4415'

PRODUCTION

1st 24 hrs. Nat. _____

1st 24 hrs. after shot _____

Gas _____ Cu. Ft.

Dry Hole _____

Abandoned _____

AUG 8 1945

19

S. J. LEWIS

Scout