


Section 35 Township 24 Range 15-W

Well No. 2 Barstow

Company Cities Service

Kipp Pool NORTH

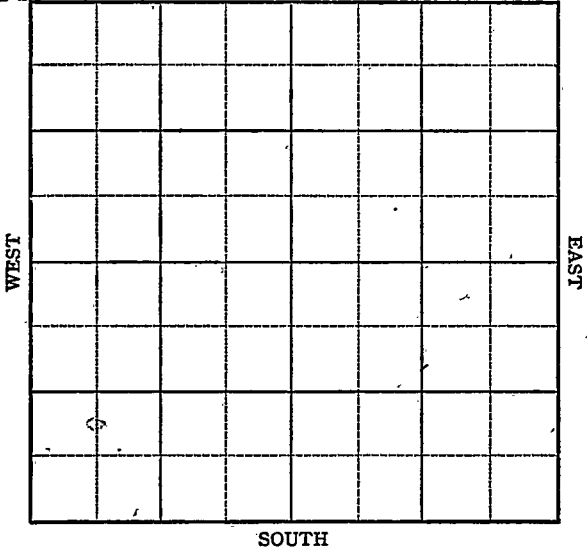



Sec. 35 Twp. 24 R. 15-W

Well No. 2 Barstow Farm

Cities Service Company


Kipp Pool
Ft. from N. Line

990
Ft. from S. Line

Ft. from E. Line

660
Ft. from W. Line

NE SW SW

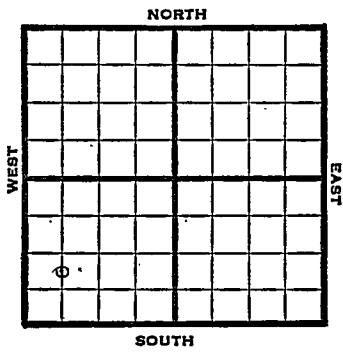

| REPORT | |
|--------|--|
| 1947 | Elev. 2016' |
| 7-16 | RUR |
| 7/22 | 10" @ 304 Drlg. 2095 |
| 7/29 | Drlg. 3517' |
| 8/6 | Drlg 4256' |
| 8/13 | Lansing 3732' Viola 4194' Simp Sd 4316' Arbuckle 4399 TD 4402' 5" @ 4400' |
| 8/20 | TD 4412' Pump 90 bbls oil in 19 hrs. |
| 8/27 | Pump 50 oil - 24 hrs. |
| 9/3 | " |
| 9/10 | Arb. 4399' 5" @ 4400' Pump 22 Pot / 5% W 40.0 Gr. TD 4412' |

COMPLETED

Map No. _____ Sec. 35 Twp. 24 R. 15W

Well No. 2 Barstow

Cities Service Company

FIRST REPORT

Contractor

NE SW SW

SECTION PLAT

| | | | |
|--|--|--|--|
| | | | |
| | | | |
| | | | |
| | | | |

_____ Ft. from N. Line

990 Ft. from S. Line

_____ Ft. from E. Line

660 Ft. from W. Line

Stafford County

Location _____

Rig up _____

Drilling and Remarks:

R U R

RECORD

Cased _____ in. _____ ft.

Sand _____

Gas _____

Oil _____

Total Depth _____

PRODUCTION

1st 24 hrs. Nat. _____

1st 24 hrs. after shot _____

Gas _____ Cu. Ft.

Dry Hole _____

Abandoned _____

Date

JUL 16 1947 19

S. J. LEWIS Scout

Map No. 83 Sec. 35 Twp. 24 R. 15W

Well No. 2 Barstow

Cities Service Company

COMPLETE

Contractor

NE SW SW

E/1, 2016
SECTION PLAT

_____ Ft. from N. Line

990 Ft. from S. Line

_____ Ft. from E. Line

660 Ft. from W. Line

| | | | |
|--|--|--|--|
| | | | |
| | | | |
| | | | |
| | | | |
| | | | |

Stafford County

RECORD

Location _____

Cased _____ in., _____ ft.

Rig up _____

Sand _____

Drilling and Remarks:

Gas _____

Cor 4399

Oil _____

5' @ 4400

Total Depth 4412

Pump 220 ft

5/10 W

40 2/3 W

PRODUCTION

1st 24 hrs. Nat. _____

1st 24 hrs. after shot _____

Gas _____ Cu. Ft.

Dry Hole _____

Abandoned _____

Date

SEP 10 1947

19

S. J. LEWIS

Scout