

Stafford


KANSAS

FORM 51 IOM 12-46 PETROL

Section 35 Township 24 Range 15W

Well No. 1 H. Giles


Company Skelly

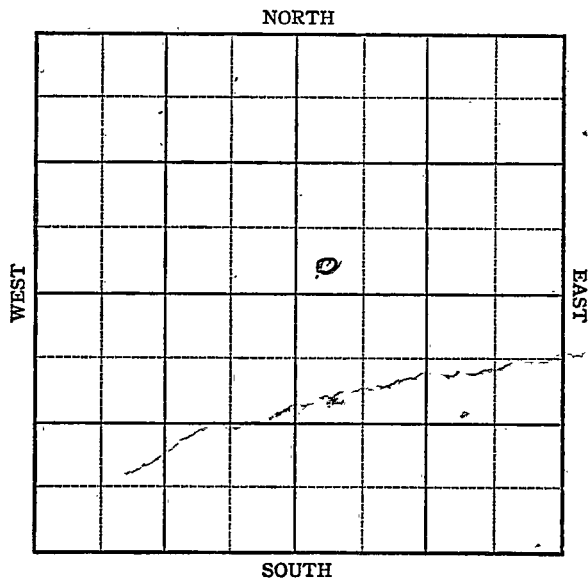

Sec. 35 **KANSAS** Twp. 24 R. 15-W **Stafford** ✓

Well No. 1 H. Giles Farm _____
_____ Skelly Company _____

_____ Ft. from N. Line
330
_____ Ft. from S. Line
_____ Ft. from E. Line
330
_____ Ft. from W. Line

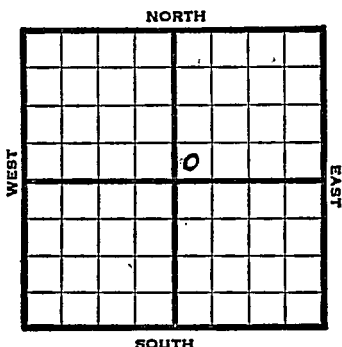

SW NE

1947 Elev. 2014' REPORT

6/4	Drlg. 850'
6/10	8" @ 965' Drlg. 2770'
6/17	Drlg. 3920'
6/25	TD 4475' Lansing 3770' Arbuckle 4445' Abandoned ABANDONED

Map No. _____ Sec. 35 Twp. 24 R. 15W

Well No. 1 H. Giles

Skelly _____ Company

FIRST REPORT _____ Contractor

SW NE


SECTION PLAT

_____ Ft. from N. Line

330 _____ Ft. from S. Line

_____ Ft. from E. Line

330 _____ Ft. from W. Line

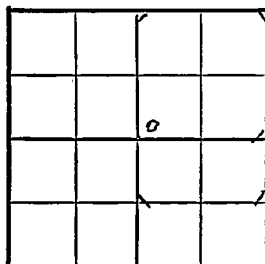

Stafford County

Location _____

Rig up _____

Drilling and Remarks:

drlg. 850'

RECORD

Cased _____ in., _____ ft.

Sand _____

Gas _____

Oil _____

Total Depth _____

PRODUCTION

1st 24 hrs. Nat. _____

1st 24 hrs. after shot _____

Gas _____ Cu. Ft.

Dry Hole _____

Abandoned _____

Date

JUN 4 1947 19 S. J. LEWIS Scout

Map No. 83 Sec. 35 Twp. 24 R. 15W

Well No. 1 H. Giles

Skelly Company

ABANDONED

Contractor

SW NE


E12014
SECTION PLAT

 Ft. from N. Line

330 Ft. from S. Line

 Ft. from E. Line

330 Ft. from W. Line

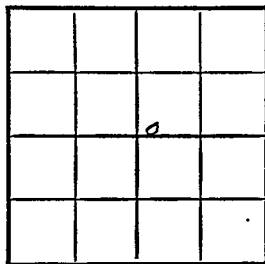

Stafford County

Location

Rig up

Drilling and Remarks:

Liams 8770

CR 4445

RECORD

Cased in, ft.

Sand

Gas

Oil

Total Depth 4475

PRODUCTION

1st 24 hrs. Nat.

1st 24 hrs. after shot

Gas Cu. Ft.

Dry Hole

Abandoned

Date

JUN 25 1947

19

S. J. LEWIS

Scout