


Section 35 Township 24 Range 15-W

Well No. #3 Barstow

Company Cities Service

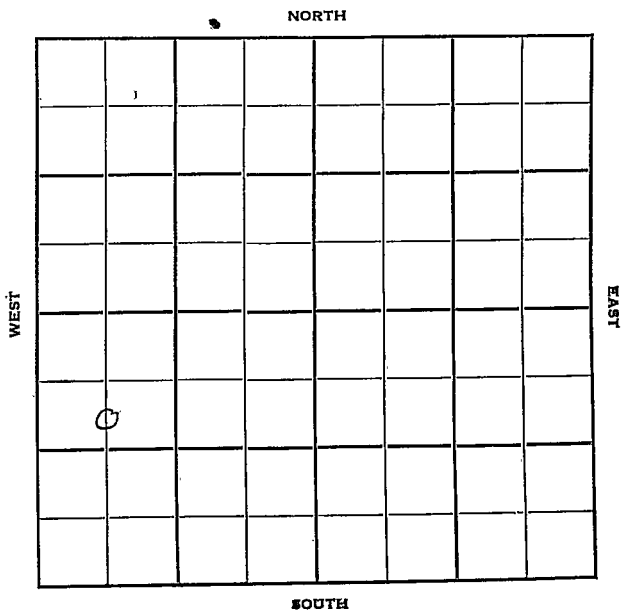

Sec. 35 Twp. 24 R. 15W

Well No. #3 Barstow Farm

Cities Service Company

Kipp Pool Contractor


990' Ft. from N. Line

\_\_\_\_\_ Ft. from S. Line

\_\_\_\_\_ Ft. from E. Line

660' Ft. from W. Line

C S L NW SW

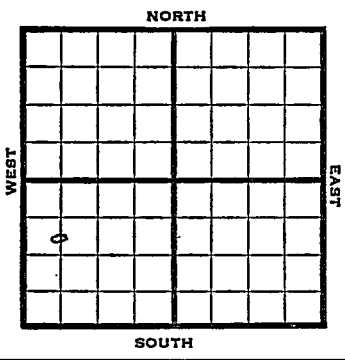

1950 **Elev 2018** **REPORT**

9/20 Spud 9-18-50  
8" @ 324'  
WOC

10/18 8" @ 324  
Lans 3746                      Simp 4327  
DST 4341-50 op 1/2 hr rec 10' mud  
Arb 4404-06  
5" @ 4405  
Cong 4124                      Kinderhook 4129  
Viola 4194  
TD 4413  
500 A  
Comp 55 bopd 165 bw  
Completed

**COMPLETED**

County Stafford State Kansas

Sec. 35 (<sup>Blk.</sup>24) (<sup>Sur.</sup>15W) (<sup>Twp.</sup>Map No.)

Operator Cities Service

Well No. 3 Farm Barstow

Elev. \_\_\_\_\_ Location C S L NW SE


990 Ft. From N Line SW

660 Ft. From W Line Quarter

Ist. Report SEP 2 n 1950

Completion \_\_\_\_\_

Remarks \_\_\_\_\_

Spudding Date 9-18-50

Drlg. Data Kipp Pool

8" @ 324 WCC

