

KANSAS

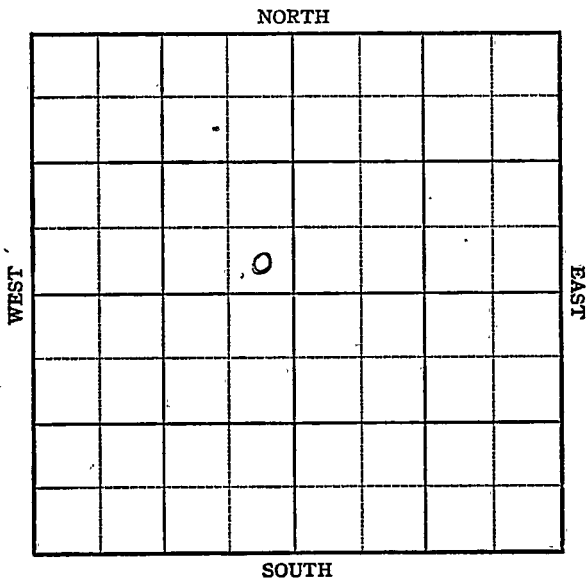
FORM 51 IOM 12-46 PETROL

Stafford

Section 35 Township 24 Range 15-W

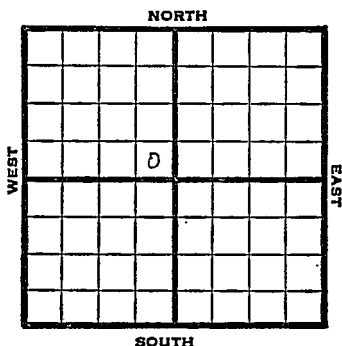
Well No. #1 Blount

Company Skelly



KANSAS

Stafford

Sec. 35 Twp. 24 R. 15-WWell No. #1 Blount FarmSkelly Company
Farmington Ft. from N. Line330 Ft. from S. Line330 Ft. from E. Line Ft. from W. Line

SE NW

1947 2015

REPORT

2/19 Location

2/26 8" @ 970'
WOC

3/4 Drlg 2900'

3/11 Lans 3758'
Viola 4209'
Drlg 4215'3/18 Simp 4321'
Arb 4404
TD 4412'
5" @ 4406
RUST

3/25 " "

4/2 2500 Acid 1500' oil in 4 hrs.

4/9 " " "

4/15 " " "

4/23 " " "

4/30 Arb 4403
5" @ 4405
2500 Acid
Pump 243 oil & 9 W Pot
Grav. 37

TD 4412' COMPLETED

Map No. 83 Sec. 35 Twp. 24 R. 15WWell No. 1 Blount

Skelly

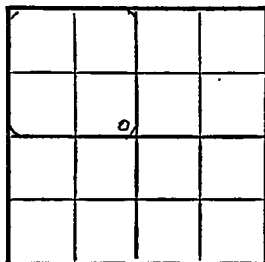
Company

FIRST REPORT

Contractor

SE NW

SECTION PLAT

 Ft. from N. Line330 Ft. from S. Line330 Ft. from E. Line Ft. from W. Line

Stafford County

Location XRig up

Drilling and Remarks:

RECORD

Cased in. ft.Sand Gas Oil Total Depth

PRODUCTION

1st 24 hrs. Nat. 1st 24 hrs. after shot Gas Cu. Ft.Dry Hole Abandoned

Date

FEB 19 1947

19

S. J. LEWIS

Scout

KANSAS
KansasMap No. 83 Sec. 35 Twp. 24 R. 15WWell No. 1 BlountSkelly

Company

COMPLETE

Contractor

SE NW

E1.2015

SECTION PLAT

Ft. from N. Line

330 Ft. from S. Line330 Ft. from E. Line

Ft. from W. Line

Stafford County

Location

Rig up

Drilling and Remarks:

Cr 8 4403
5" @ 4405
2500 acid
Pump 243 oil
49 W 128

87 2/3

RECORD

Cased _____ in., _____ ft.

Sand _____

Gas _____

Oil _____

Total Depth _____

PRODUCTION

1st 24 hrs. Nat. _____

1st 24 hrs. after shot _____

Gas _____ Cu. Ft.

Dry Hole _____

Abandoned _____

Date

APR 30 1947

19

S. J. LEWIS

Scout