

Section 35 Township 24 Range 15 WWell No. # 1 GilesCompany Lindas Oil

NORTH

				0			

SOUTH

Stafford

MISSAS

Sec. 35 Twp. 24 R. 15W


Well No. #1 Giles Farm

Lindas Oil Company

Lindas - Contr. Contractor

Wildcat

Ft. from N. Line

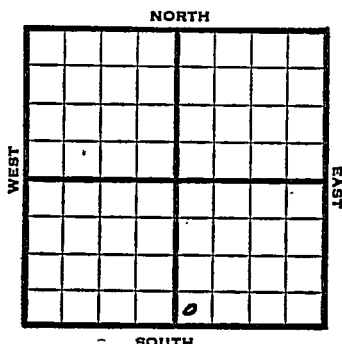

330' Ft. from S. Line

Ft. from E. Line

330' Ft. from W. Line

SW SW SE

1952

Elev. 2012' REPORT

7/23

Spud 7-19-52

8" @ 202

Drlg. 2170

7/30

Anhy 965 Br Li 3758 Lens. 3773

Drlg. 3918'

8/6

Spud date 7-19-52

D&A TD 4477

8" @ 202' Anhy 965

Br lime 3758 Lens. 3773

Cong 4156 Kh 4209

Viola 4270 Simp 4365

Simp sd 4400 SSO 4400-05

DST 4400-4417 opn $\frac{1}{2}$ hr

Rec. 8' vsocm 770# Arb. 4447

TD 4477

D&A

ABANDONED

County **Stafford** State **Kansas**

Sec. **35** (Blk. **24** (Sur. **15W** Map No.

Operator **Lindas Oil**

Well No. 1 Farm Giles

Elev.	2012	Location	SW	SW	SE
-------	------	----------	----	----	----

0

FIRST REPORT

330 Ft. From S Line SE

330 Ft. From ~~ET~~ Line Quarter

1st. Report JUL 23 1952

Completion

Remarks	Skelly - support
---------	------------------


Lindas - Contr.

Spudding Date 7-19-52

Drig. Data **Wildcat**

8th @ 202 drlg. 2170

County Stafford State Kansas
 Sec. 35 (Blk. 24 (Sur. 15W Map No.
 Twp.) Rge.)
 Operator Lindas Oil
 Well No. 1 Farm Giles
 Elev. 2012 Location SW SW SE

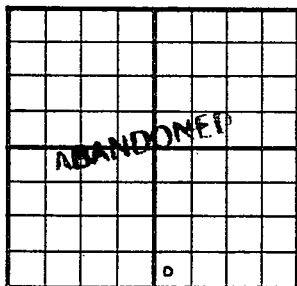

330 Ft. From S Line SE
330 Ft. From W Line Quarter
 1st. Report
 Completion AUG 6 1952
 Remarks Wildcat
Lindas - Contr.
 Spudding Date 7-19-52

Drlg. Data D & A TD 4477
8" @ 202 Anhy 965 Br. lime 3758
Lans. 3773 Cong. 4156 Kh. 4209
Viola 4272 Simp. 4365 Simp. sd. 4400
SSO 4400-05 DST 4400-4417 open $\frac{1}{2}$ hr.
Rec. 8' vsocm 770# Arb. 4447 TD 4477
D & A

J. G. McGEHEE