


Edwards

KANSAS

SECTION 35 TOWNSHIP 24 RANGE 16W

WELL NO. #1 Kearny Unit

COMPANY Branine & Holl

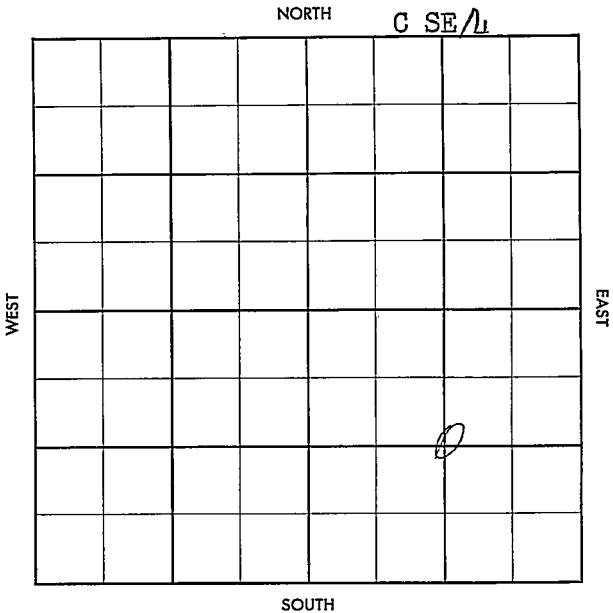

SEC.

35

TWP.

24 S

R.

16 W

WELL NO.

1 Kearny Unit

FARM

COMPANY

Branine & Holl

CONTRACTOR

Herndon Drlg.


Wildcat

_____ FT. FROM N. LINE

_____ FT. FROM S. LINE

_____ FT. FROM E. LINE

_____ FT. FROM W. LINE

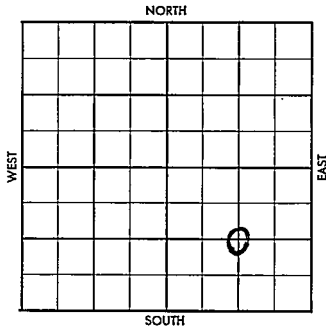

C SE/4

SDX-3/4 Mile .

ELEVATION

1957

2065

REPORT

5/15

Comm. 5-10-57
 8" @ 266/200
 Drlg. 2238'

WILDCAT

FORM 513 SUNRAY

County Edwards Elev. _____
 Sec. 35 Twp. 24 Rge. 16W
 Company Branine & Holl
 Farm Name Kearny Unit No. 1

TOPS	DEPTH	LOG	DATUM	Loc. in Sec.
Anh.				C SE/4
Tr.				
H.				
Tr.				
Dg.				
Bl.				
L.				Geol. J. Gould
K.C.				Contr.
B.K.C.				Herndon Drlg.
Ce.				Pool
C.				Wildcat
M.				
M.				
K.				
Mz.				
Mq.				
V.				
S.				
S.				
A.				
R.				
Pe.				
G.				
T.D.				

FIRST REPORT

MAY 15 '57

3/4 mile

Date Comm. 5-10-57
8" @ 266/200, Drlg. 2238

W. H. YAN

County Edwards Elev. 2065
 Sec. 35 Twp. 24 Rge. 16W
 Company Brahine & Holl
 Farm Name Kearny Unit No. 1

TPS DEPTH LOG DATUM Loc. in Sec.
 C SE/4

TPS	DEPTH	LOG	DATUM	Loc. in Sec.
		3706		
Fr				
Bt	3844	3844		
L.	3853	3853		
K.C.				Geol. J. Gould
B.K.C.				Contr.
Ce.				Herndon Drilg
C.				Pool
M.	4284?	4262		Wildcat
M. chat		4284		
K. sd		4316		
Mz.				
Mo.				
V.				
S.				
S.				
A.				
R.				
PE.				
G.				
T.D.	4365			

Date Comm. 5-10-57

8" @ 266/200, Drilg. 2238 MAY 22 '57 @ 4000
 MAY 23 '57 5 1/2 4365/75 R79 GRN
 (holding some dope) ga. little
 gas in Miss JUN 5 '57 JUL 2 '57 CO
 4330 36/4286-92 no test
 Frac 5x5 test GSO - decr.
 to 0 + gas 1,450 MCFG JUN 19 '57
 Back Press test. 861# ga 309
 MCFG 51P1377# ga 1.184 MCFG.