

KANSAS

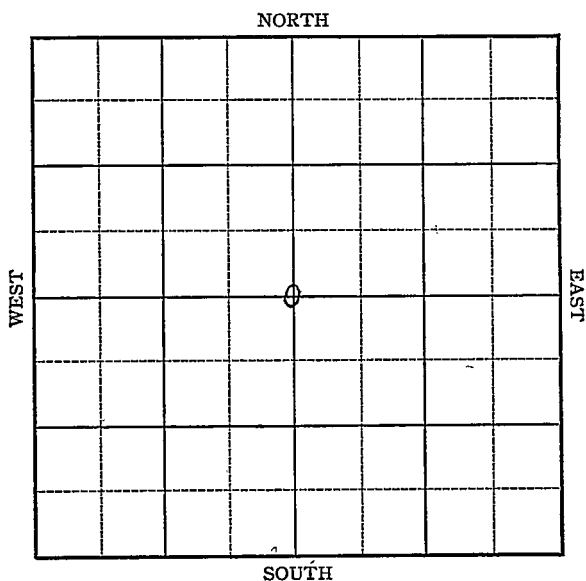
Kearney

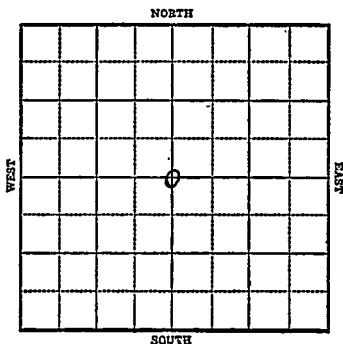
FORM 51 5M 1-42 PETROL

Section 35 Township 24 Range 35-W

Well No. #1 Kriete

Company Fin-Ker



Sec. 35 Twp. 24 R. 35-WWell No. #1 Kriete FarmFin-Ker Company2640 Ft. from N. Line Ft. from S. Line2640 Ft. from E. Line Ft. from W. Line

1943

R E P O R T

8/11 Location

8/18 Derrick

8/25 "

9/1 "

9/8 Drlg. 475

9/15 Drlg. 1816'

9/22 T.D. 2484 fsg.

9/29 " " "

10/6 7" @ 2474' ~
Rust

10/13 "

10/20 Drlg. 2600

10/27 T.D. 2699-2 M Gas.

11/3 2000 acid CO ;

11/10 " " "

11/17 Total of 30000 Acid SD

OVER

1943
11/24

7" @ 2474'
Sand 2474
30000 Acid
18,400,000 Gas
TD 2699'

COMPLETED

Kearney

KANSAS
 Map No. 1111 Sec. 35 Twp. 24 R. 35W

Well No. 1 Kriete

Fin-Ker

Company

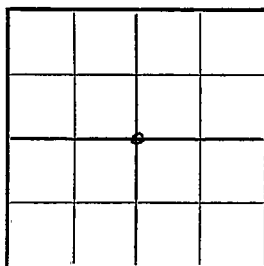
FIRST REPORT

Contractor

C Sec. 12640 Ft. from N. Line Ft. from S. Line2640 Ft. from E. Line Ft. from W. Line

HOUGHTON POOL

SECTION PLAT

Location XXXRig up Drilling and Remarks:

RECORD

Cased in., ft.Sand Gas Oil Total Depth

PRODUCTION

1st 24 hrs. Nat. 1st 24 hrs. after shot Gas Cu. Ft.Dry Hole Abandoned

Date

AUG 11 1943

19

S. J. LEWIS

Scout

KANSAS

Map No. 1111 Sec. 35 Twp. 24 R. 35WWell No. 1 KrieteFin-Ker

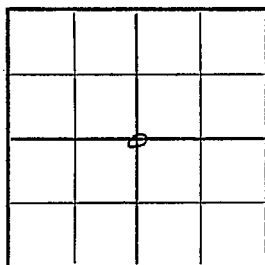
Company

COMPLETED

Contractor

C SEC.

SECTION PLAT

2640 Ft. from N. Line Ft. from S. Line2640 Ft. from E. Line Ft. from W. LineHoughton PoolLocation Rig up

Drilling and Remarks:

*Sand 2474**7" @ 2474**30000 Gall**18,400,000 Gall*

RECORD

Cased in., ft.Sand Gas Oil Total Depth 2688

PRODUCTION

1st 24 hrs. Nat. 1st 24 hrs. after shot Gas Cu. Ft.Dry Hole Abandoned

Date

NOV 24 1943 19S. J. LEWIS Scout