


18-24-36W

WELL LOG BUREAU--KANSAS GEOLOGICAL SOCIETY
412 Union National Bk. Bldg., Wichita, Kansas

Company - CHAMPLIN REFG. CO.
Farm - Loucks "A" No. 1

SEC. 18 T. 24 R. 36W
SE NE SW
2310' fr WL & 1380' fr SL SW 1/4

Total Depth. 2703' R.B.
Comm. 5-14-49 Comp. 5-24-49
Shot or Treated.
Contractor.
Issued. 8-13-49

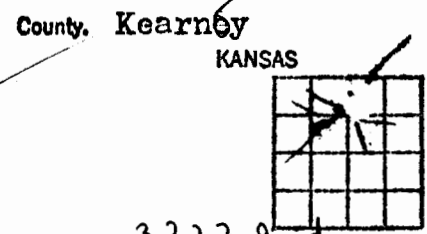

CASING:
8-5/8" OD 697.26' Cem. W/375 Sx.
5-1/2" 2675.43' Cem. W/700 Sx.

Elevation. 3223' 9nd
Production. 2,303,000 gas

Figures Indicate Bottom of Formations.

sand & clay	200
sand, shale, lime	
& clay	455
clay & lime	680
red bed	955
redbed, sand &	
anhydrite	1330
shale, anhy.&lime	1600
red rock	1705
red rock & anhy.	1825
anhy. & lime	1896
lime & shale	1990
lime, shale &	
red bed	2240
lime & shale	2445
lime	2480
lime & shale	2685
lime	2703 RB
Total Depth	

Tops:

Hollenberg	2476
Herrington	2512
Krider	2532
Winfield	2564
Towenda	2633
Ft. Riley	2672