

STATE CORPORATION COMMISSION OF KANSAS
OIL & GAS CONSERVATION DIVISIONWELL COMPLETION OR RECOMPLETION FORM
ACO-1 WELL HISTORY

DESCRIPTION OF WELL AND LEASE

Operator: license # 5363
name BEREXCO INC.
address 970 Fourth Financial Center
City/State/Zip Wichita, KS 67202

Operator Contact Person Evan C. Mayhew
Phone 316-265-3511

Factor: license # 5147
name BEREDCO INC.

Wellsite Geologist Charles B. Spradlin
Phone (316) 683-9026
CHASER

Designate Type of Completion

☒ New Well ☐ Re-Entry ☐ Workover

☐ Oil ☒ SWD ☐ Temp Abd
☐ Gas ☐ Inj ☐ Delayed Comp.
☐ Dry ☐ Other (Core, Water Supply etc.)

If OWWO: old well info as follows:

Operator
Well Name
Comp. Date Old Total Depth

WELL HISTORY

Drilling Method: ☒ Mud Rotary ☐ Air Rotary
7/88 8/30/88 10-7-88
Spud Date Date Reached TD Completion Date
5140' 4400'
Depth PBTD

Amount of Surface Pipe Set and Cemented at 1825' feet

Multiple Stage Cementing Collar Used? ☒ Yes ☐ No

If Yes, Show Depth Set 3170 feet

If alternate 2 completion, cement circulated
from feet depth to w/ SX cml

API NO. 15-093-20,949

County Kearny

NW NW SE Sec 18 Twp 24S Rge 36W. X West
(location)

2310

Ft North from Southeast Corner of Section

2310

Ft West from Southeast Corner of Section

(Note: locate well in section plat below)


Lease Name NEFF Well# 2-18

Field Name

Producing Formation Kansas City

Elevation: Ground 3208 KB 3220

Section Plat

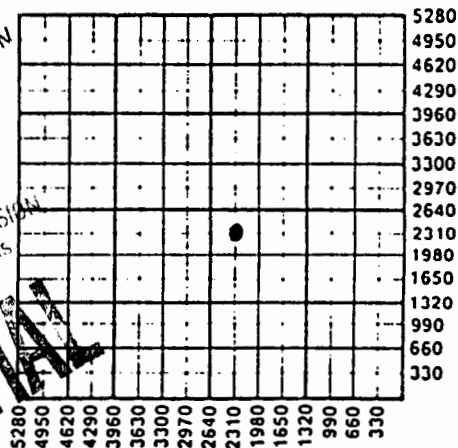

WATER SUPPLY INFORMATION

Source of Water:

Division of Water Resources Permit #

☐ Groundwater Ft North From Southeast Corner and
(Well) Ft. West From Southeast Corner of
Sec Twp Rge ☐ East ☐ West

☐ Surface Water Ft North From Southeast Corner and
(Stream, Pond etc.) Ft West From Southeast Corner
Sec Twp Rge ☐ East ☐ West

☐ Other (explain)
(purchased from city, R.W.D.#)

Disposition of Produced Water: ☐ Disposal
☐ Repressuring

Docket #

INSTRUCTIONS: This form shall be completed in duplicate and filed with the Kansas Corporation Commission, 200 Colorado Derby Building, Wichita, Kansas 67202, within 90 days after completion or recompletion of any well. Rules 82-3-130 and 82-3-107 apply.

Information on side two of this form will be held confidential for a period of 12 months if requested in writing and submitted with the form. See rule 82-3-107 for confidentiality in excess of 12 months.

One copy of all wireline logs and drillers time log shall be attached with this form. Submit CP-4 form with all plugged wells. Submit CP-111 form with all temporarily abandoned wells.

All requirements of the statutes, rules, and regulations promulgated to regulate the oil and gas industry have been fully complied with and the statements herein are complete and correct to the best of my knowledge.

Signature Evan C. Mayhew

Engineer Date 11-9-88

Described and sworn to before me this 9 day of November 19 88

Notary Public

Notary Commission Expires 3-20-90

K.C.C. OFFICE USE ONLY

☒ Letter of Confidentiality Attached
☒ Wireline Log Received
☐ Drillers Timelog Received

Distribution

☐ KCC ☐ SWD/Rep ☐ NGPA
☐ KGS ☐ Plug ☐ Other
(Specify)

Form ACO-1 (7-84)